


Section 3 Township 31 Range 5 E

Well No. # 1 Cloud

Company Earl Wakefield

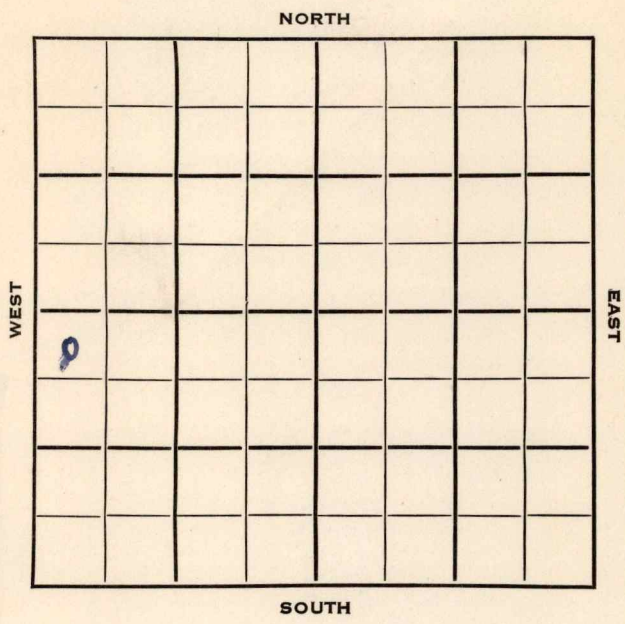

Cowley

KANSAS ✓

Sec. 3 Twp. 31 R. 5E

Well No. #1 Cloud Farm

Earl Wakefield Company

Wakefield Contractor


330 Ft. from N. Line

\_\_\_\_\_ Ft. from S. Line

\_\_\_\_\_ Ft. from E. Line

330 Ft. from W. Line

NW NW SW

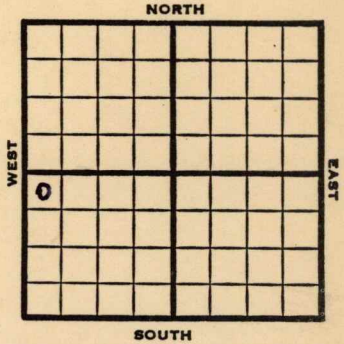

1952

Elev. --

REPORT

12/3

MIM

12/23

Spud 12-7-52 D & A TD 3035'  
 8" @ 100 KC 2299 Bart 2935'  
 DST 2490-2502 open 1 hr. rec 30' SOCM  
 650# Miss 3002' TD 3035  
 DST 2935-65 open 1 hr. rec 20' mud  
 D & A

**ABANDONED**



