


Map No. 75 Sec. 3 Twp. 31 R. 5

Well No. 1 Swayer Farm
Dickensetal Company

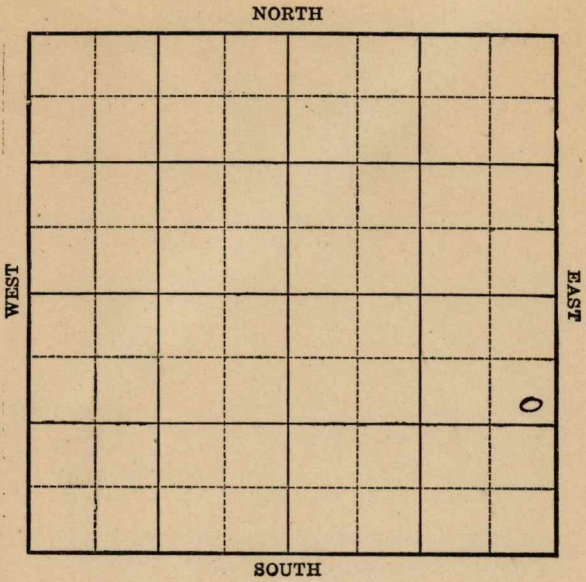

Location _____

Rig up _____

Drilling Remarks:

Drilling Remarks:

RECORD

PRODUCTION

Cased _____ in. _____ ft.

1st 24 hrs Nat. _____

Sand _____

1st 24 hrs. after shot _____

Gas _____

Gas _____ cu. ft.

Oil _____

Dry Hole _____

Total Depth _____

Abandoned _____

Map No. 11 Sec. 3 Twp. 31 R. 5


Well No. 1 Swayer Farm
Dickers et al Company

1120 Ft. from N. Line

_____ Ft. from S. Line

200 Ft. from E. Line

_____ Ft. from W. Line

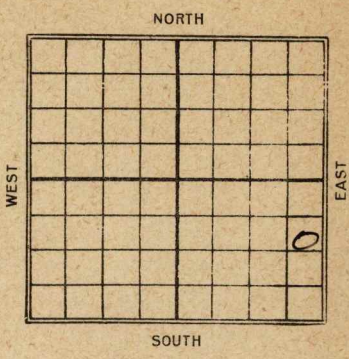

Date 1924

REPORT

6/10

Qty 300

7/16

Qty. @ 1900'

10/8

Top Line 3020

W. Line 3475-85

H.F.W. 3483-85

D. & G. 3510'

2 **KANSAS** Map No. Sec. 3 Twp. 31 R. 5

Well No. # 1 Swayer

Vickers et al Company

Contractor

FIRST REPORT

SECTION PLAT

1120 Ft. from N. Line

Ft. from S. Line

200 Ft. from E. Line

Ft. from W. Line

			0

Location

Rig up

Drilling and Remarks:

R.O. G.
6/11 20 lg 3 1/2

RECORD

Cased in., ft.

Sand

Gas

Oil

Total Depth

PRODUCTION

1st 24 hrs. Nat.

1st 24 hrs. after shot

Gas Cu. Ft.

Dry Hole

Abandoned

Date

JUN 10 1924

M. A. BENEAR

152 **KANSAS** Sec. 3 Twp. 31 R. 5

Well No. 1 sampler

Vickers Ltd Company

Contractor

ABANDONED SECTION PLAT

1120 Ft. from N. Line

----- Ft. from S. Line

200 Ft. from E. Line

----- Ft. from W. Line

			0

Location -----

Rig up -----

Drilling and Remarks:

Tap L. 3020
 Wilcox 3475-75
 14.5 ft. w. 3483-75
 2049 3510'

RECORD

Cased ----- in., ----- ft.

Sand -----

Gas -----

Oil -----

Total Depth -----

PRODUCTION

1st 24 hrs. Nat. -----

1st 24 hrs. after shot -----

Gas ----- Cu. Ft.

Dry Hole -----

Abandoned -----

Date

OCT 8 1924

M. A. BENEAR

192

Scout