


Section 6 Township 20 Range 10-W

Well Number #8 Specht

Company Stanolind

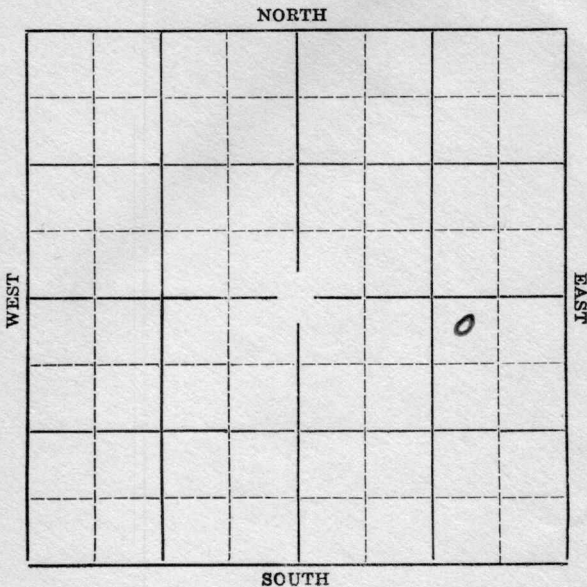

KANSAS

Rice

Sec. 6 Twp. 20 R. 10W

Well No. #8 Specht Farm

Stanolind Company


330' Ft. from N. Line

_____ Ft. from S. Line

990' Ft. from E. Line

_____ Ft. from W. Line

Elev. 1791

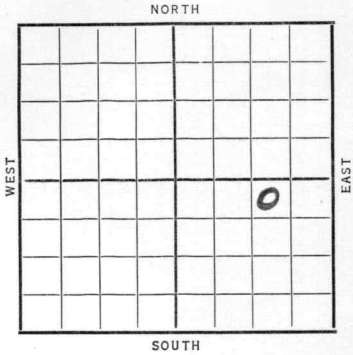

| Date | REPORT |
|------------------|---------------------------|
| 1936 | |
| 10/21 | Cellar. |
| 10/29 | Rigging up. |
| 11/6 | 13" @ 198 WOC |
| 11/12 | Drlg. 1920 |
| 11/19 | Drlg. 3212'. |
| 11/27 | Sil. 3300 set 7". |
| | T. D. 3309'. Rust. |
| 12/3 | Swabb 100 bbls. per hour. |
| | |
| 12/9 | Sil. 3300 |
| | Pot. 2644 Nat. |
| | T.D. 3313 |
| COMPLETED | |

Map No. 46 Sec. 6 Twp. 20 R. 10W

Well No. J Speck

Standard Company

Contractor

SECTION PLAT

| | | | |
|--|--|--|---|
| | | | |
| | | | |
| | | | 0 |
| | | | |

330 Ft. from N. Line

_____ Ft. from S. Line

990 Ft. from E. Line

_____ Ft. from W. Line

FIRST REPORT

Location _____

Rig up _____

Drilling and Remarks:

Oil

RECORD

Cased _____ in., _____ ft.

Sand _____

Gas _____

Oil _____

Total Depth _____

PRODUCTION

1st 24 hrs. Nat. _____

1st 24 hrs. after shot _____

Gas _____ Cu. Ft.

Dry Hole _____

Abandoned _____

Date

OCT 21 1936 19

S. J. LEWIS

Scout

KANSAS

Map No. 46 Sec. 6 Twp. 20 R. 10W

Well No. J Specht

Stairwind Company

Contractor

SECTION PLAT

330 Ft. from N. Line

_____ Ft. from S. Line

990 Ft. from E. Line

_____ Ft. from W. Line

| | | | |
|--|--|--|---|
| | | | |
| | | | |
| | | | o |
| | | | |

COMPLETED

Location _____

Rig up _____

Drilling and Remarks:

Sil 3300
Pr 8-2644
Nat.

RECORD

Cased _____ in., _____ ft.

Sand _____

Gas _____

Oil _____

Total Depth 3313

PRODUCTION

1st 24 hrs. Nat. _____

1st 24 hrs. after shot _____

Gas _____ Cu. Ft.

Dry Hole _____

Abandoned _____

Date

DEC 9 1936

S. J. LEWIS

Scout