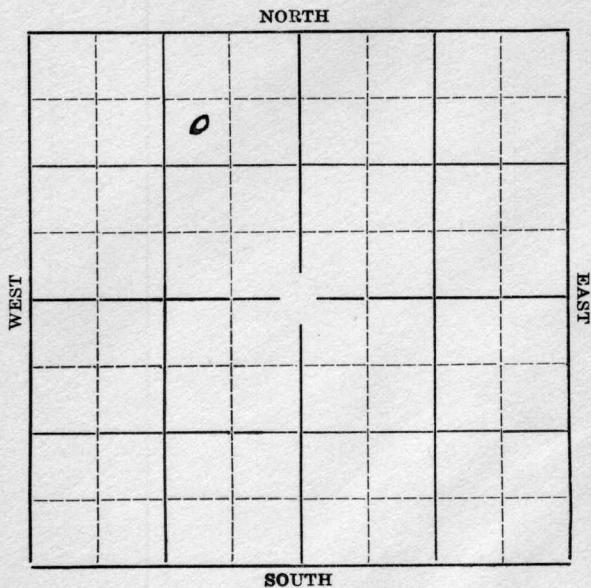


Section 6 Township 20 Range 10-WWell Number #9-BerscheidtCompany Tatlock et al

Rice

Map No. KANSAS Sec. 6 Twp. 20 R. 10W

Well No. #9 Berscheidt Farm

Tatlock et al Company


990' Ft. from N. Line

_____ Ft. from S. Line

990' Ft. from E. Line

_____ Ft. from W. Line

Elev. 1775

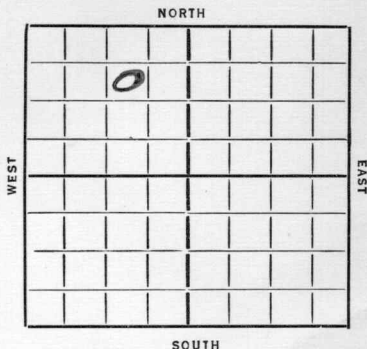

~~1936~~ 1936

REPORT

8/5 Location

8/13 Cellar.

8/20 Rig.

8/27 10" @ 173'. Drlg. 675'.

9/3 Drlg. 2860'.

9/10 Siliceous 3269'. Set 7". TD 3270'.
Rigging up standard tools.

9/18 --

9/24 Clean out.

10/1 TD 3281' testing.

10/7/36-Sil. 3269'.
T.D. 3281'.
Potential 2153 BB/s.

COMPLETED

KANSAS

Map No. 46 Sec. 6 Twp. 20 R. 10WWell No. 9 BerscheidtHattrop & Dal Company

Contractor

SECTION PLAT

	0		

990 Ft. from N. Line

_____ Ft. from S. Line

990 Ft. from E. Line

_____ Ft. from W. Line

FIRST REPORT

Location ✓

Rig up _____

Drilling and Remarks:

RECORD

Cased _____ in., _____ ft.

Sand _____

Gas _____

Oil _____

Total Depth _____

PRODUCTION

1st 24 hrs. Nat. _____

1st 24 hrs. after shot _____

Gas _____ Cu. Ft.

Dry Hole _____

Abandoned _____

Date

AUG 5 1936

19

S. J. LEWIS Scout

Map No. 46 Sec. 6 Twp. 28 R. 10WWell No. 9 BerscheidMa Hook Company

Contractor

SECTION PLAT

	0		

990 Ft. from N. Line

Ft. from S. Line

990 Ft. from E. Line

Ft. from W. Line

COMPLETED

Location _____

Rig up _____

Drilling and Remarks:

Sil 8269P 82153

RECORD

Cased _____ in., _____ ft.

Sand _____

Gas _____

Oil _____

Total Depth 3281

PRODUCTION

1st 24 hrs. Nat. _____

1st 24 hrs. after shot _____

Gas _____ Cu. Ft.

Dry Hole _____

Abandoned _____

Date

OCT 7 1936 19S. J. LEWIS Scout