

Well Number 10 Specht

A 10x10 grid map with cardinal directions labeled: NORTH (top), SOUTH (bottom), WEST (left), and EAST (right). A small black circle is located in the bottom-right corner of the grid.

KANSAS

Rice

Map No. Sec. 6 Twp. 20 R. 10W

Well No. 10 Specht Farm

Stanolind Company

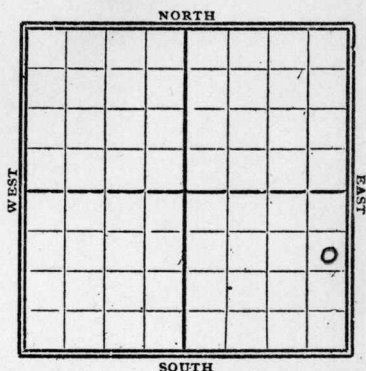
990 Ft. from N. Line

..... Ft. from S. Line

330 Ft. from E. Line

..... Ft. from W. Line

Elev. 1798

Date
1936

REPORT

12-9 Rig

12/17 Spud 190'.

12/24 13" @ 197'. Drlg. 2300'.

12/29 Sil. 3313' Set 6". RUST.

1937

1/7 RUST.

1/14 T. D. 3328'. Swabbed 30 bbls.
per hr. off bottom.

1/20 Sil. 3313'. T. D. 3328'.
2000 acid.
Pot. 2663.

COMPLETED

KANSAS

Map No. 46 Sec. 6 Twp. 20 R. 10W.

Well No. 10 Speck

Standind Company

Contractor

SECTION PLAT

990 Ft. from N. Line

_____ Ft. from S. Line

830 Ft. from E. Line

_____ Ft. from W. Line

			0

FIRST REPORT

Location _____

Rig up _____

Drilling and Remarks:

Rig

RECORD

Cased _____ in., _____ ft.

Sand _____

Gas _____

Oil _____

Total Depth _____

PRODUCTION

1st 24 hrs. Nat. _____

1st 24 hrs. after shot _____

Gas _____ Cu. Ft.

Dry Hole _____

Abandoned _____

Date

DEC 9 1936 19

S. J. LEWIS Scout

Map No. 46 Sec. 6 Twp. 20 R. 10WWell No. 10 Speech 8.Standard Company

Contractor

SECTION PLAT

990 Ft. from N. Line

_____ Ft. from S. Line

330 Ft. from E. Line

_____ Ft. from W. Line

COMPLETED

Location _____

Rig up _____

Drilling and Remarks:

Oil 33132000 acidP.O. 2668

RECORD

Cased _____ in., _____ ft.

Sand _____

Gas _____

Oil _____

Total Depth 3328.

PRODUCTION

1st 24 hrs. Nat. _____

1st 24 hrs. after shot _____

Gas _____ Cu. Ft.

Dry Hole _____

Abandoned _____

Date

JAN 20 1937 19

S. J. LEWIS Scout