




Map No. **KANSAS** Sec. 7 Twp. 31 R. 5<sup>E</sup>

Well No. 1- Roggers Farm  
Mid-Kansas Oil & Gas Company

NORTH

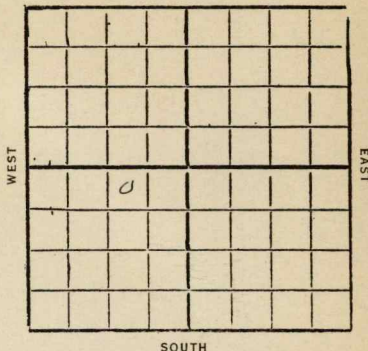

330 Ft. from N. Line

\_\_\_\_\_ Ft. from S. Line

490 Ft. from E. Line

\_\_\_\_\_ Ft. from W. Line

1932

Date

REPORT

|      |                    |
|------|--------------------|
| 6/22 | Bedg rig           |
| 6/29 |                    |
| 7/6  | Rgn up             |
| 7/13 | 15" 320            |
|      | Dreg 820'          |
| 7/20 | 12" 1016           |
|      | HFW 1460           |
|      | Rrg 10" 1484       |
| 7/27 | Dreg 1810'         |
| 8/3  | 10" 1800           |
|      | HFW 1910           |
|      | TID 1997 U/B 10"   |
| 8/10 | 10" 1963           |
|      | Top K.C. lime 2260 |
|      | Dreg 2390'         |
| 8/17 | Top lime 2902      |
|      | dreg 2950'         |
| 8/24 | HFW 2970-78        |
|      | 8" 2990            |
|      | Base lime 3255'    |
|      | HFW 3368           |
|      | dreg 3405'         |

8/31- SD 3405'

9/7- Top lime 2902

Base " 3255

TD 3526

Dry & Abandon

2 KANSAS

Map No. \_\_\_\_\_ Sec. 7 Twp. 31 R. 5 E

Well No. 1 Rogers

Mis. Kansas Oil Gas Company

Contractor \_\_\_\_\_

## FIRST REPORTS


330 Ft. from N. Line

\_\_\_\_\_ Ft. from S. Line

990 Ft. from E. Line

\_\_\_\_\_ Ft. from W. Line

## SECTION PLAT

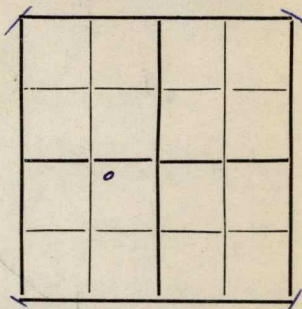

Location \_\_\_\_\_

Rig up \_\_\_\_\_

Drilling and Remarks:

Blow Rig

## RECORD

Cased \_\_\_\_\_ in., \_\_\_\_\_ ft.

Sand \_\_\_\_\_

Gas \_\_\_\_\_

Oil \_\_\_\_\_

Total Depth \_\_\_\_\_

## PRODUCTION

1st 24 hrs. Nat. \_\_\_\_\_

1st 24 hrs. after shot \_\_\_\_\_

Gas \_\_\_\_\_ Cu. Ft.

Dry Hole \_\_\_\_\_

Abandoned \_\_\_\_\_

Date

JUN 22 1932

192

CHAS. L. SHERWOOD

Scout

Cawley

2 KANSAS

Map No. \_\_\_\_\_ Sec. 7 Twp. 31 R. 5

Well No. 1 Rogers

Mid-Kansas Oil &amp; Gas Company

Contractor

COMPLETED

## SECTION PLAT

330 Ft. from N. Line

\_\_\_\_\_ Ft. from S. Line

990 Ft. from E. Line

\_\_\_\_\_ Ft. from W. Line

|  |  |  |  |
|--|--|--|--|
|  |  |  |  |
|  |  |  |  |
|  |  |  |  |
|  |  |  |  |
|  |  |  |  |
|  |  |  |  |

ABANDONED

Location \_\_\_\_\_

Rig up \_\_\_\_\_

Drilling and Remarks:

Top Limb 290

Base limb 355

## RECORD

Cased \_\_\_\_\_ in., \_\_\_\_\_ ft.

Sand \_\_\_\_\_

Gas \_\_\_\_\_

Oil \_\_\_\_\_

Total Depth 3524

## PRODUCTION

1st 24 hrs. Nat. \_\_\_\_\_

1st 24 hrs. after shot \_\_\_\_\_

Gas \_\_\_\_\_ Cu. Ft.

Dry Hole ☒Abandoned ☒

Date

SEP 7 1932

CHAS. L. SHERWOOD

192 \_\_\_\_\_ Scout