KANSAS


Barton

FORM 51 IOM 12-46 PETROL

Section 16 Township 18 Range 11W

Well No. 1 Drews "A"

Company Bridgeport

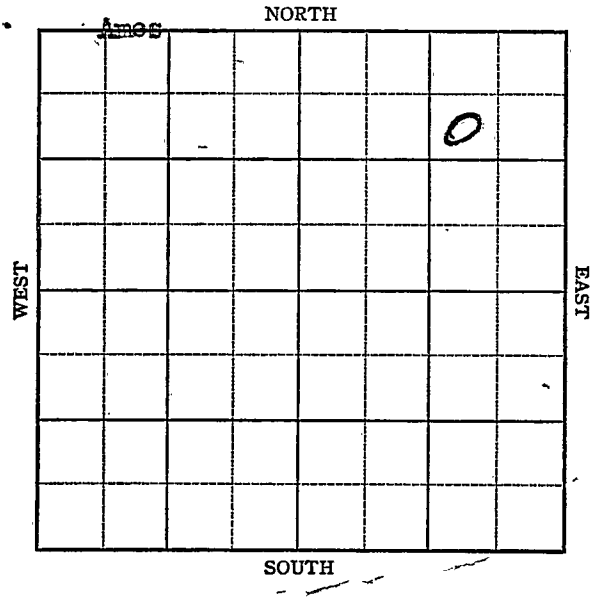

FORM 252-A
5M 12-46 PETROL

KANSAS Barton County

Sec. 16 Twp. 18 R. 11-W

Well No. 1 Drews "A" Farm

Bridgeport Company

Ames Pool


990 Ft. from N. Line

Ft. from S. Line

990 Ft. from E. Line

Ft. from W. Line

SW NE NE

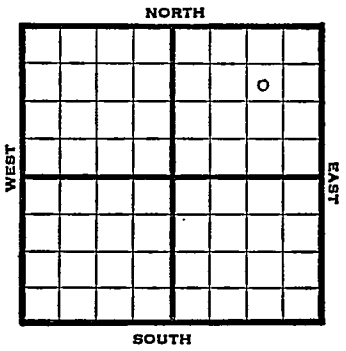

1947	El. 1786' REPORT
7/30	8" @ 277 Drlg. 1750'
8/6	Lansing 3058' Drlg 3160'
8/13	Arb. 3346' T.D. 3360' Abandoned.

ABANDONED

Form 26 200 Bks. 10-46 Petrol

Ames Pool

Kansas

Map No. _____ Sec. 16 Twp. 18 R. 11W

Well No. 1 Drews "A"

Bridgeport Company

FIRST REPORT Contractor

SW NE NE


990 Ft. from N. Line

_____ Ft. from S. Line

990 Ft. from E. Line

_____ Ft. from W. Line

SECTION PLAT

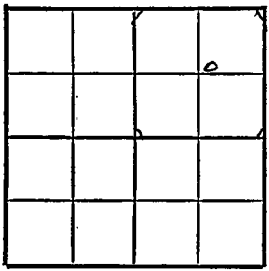

Barton County

Location _____

Rig up _____

Drilling and Remarks:

8" @ 277

drlg. 1750

RECORD

Cased _____ in., _____ ft.

Sand _____

Gas _____

Oil _____

Total Depth _____

PRODUCTION

1st 24 hrs. Nat. _____

1st 24 hrs. after shot _____

Gas _____ Cu. Ft.

Dry Hole _____

Abandoned _____

Date

JUL 30 1947 19 S. J. LEWIS Scout

Form 26 200 Bks. 10-46 Petrol

Ames Pool

Kansas

Map No. 55 Sec. 16 Twp. 18 R. 11W

Well No. 1 Drews "A"


Bridgeport Company

ABANDONED Contractor

SW NE NE

E 4178

SECTION PLAT

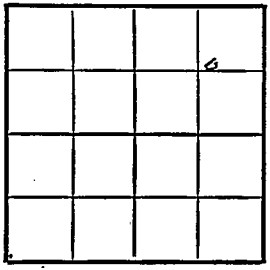

990 Ft. from N. Line

Ft. from S. Line

990 Ft. from E. Line

Ft. from W. Line

Barton County

Location

Rig up

Drilling and Remarks:

CeX3846

RECORD

Cased in., ft.

Sand

Gas

Oil

Total Depth 3360

PRODUCTION

1st 24 hrs. Nat.

1st 24 hrs. after shot

Gas Cu. Ft.

Dry Hole

Abandoned

Date

AUG 13 1947 19

S. J. LEWIS Scout