


Section 15 Township 18 Range 11W

Well No. #4 Drews (B)

Company Aklahoma-Texas Trust

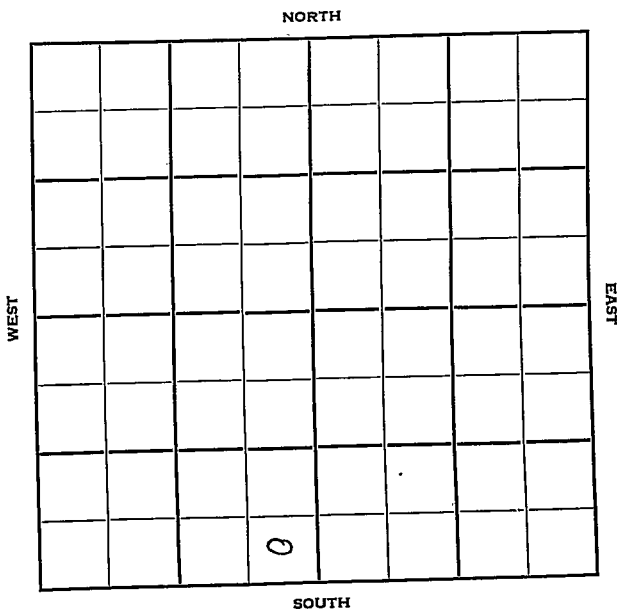

Sec. 15 Twp. 18 R. 11W

Well No. #4 Drews (B) Farm

Aklahoma-Texas Trust Company

Lindsley Contractor


\_\_\_\_\_ Ft. from N. Line

330 Ft. from S. Line

330 Ft. from E. Line

\_\_\_\_\_ Ft. from W. Line

SE SE SW

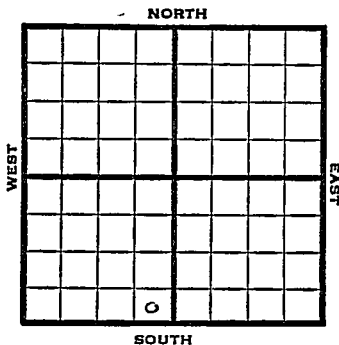

1952

Elev. 1784'

REPORT

9/10 RU

9/17 8" @ 280' "  
Lans. 3024'  
Drlg. 3045'

9/24 NR

10/1 "

10/8 DST 3024-44 flowed oil  
Arb 3306-10 RTD  
5" @ 3310  
DD 3220 TD  
S/12 BOPH, POP

10/15 "

10/22 NR

10/29 "

11/5 "

11/12 "

11/19 Spud 9-8-52  
Oil well TD 3320' 8" @ 280  
Lans. 3024'  
DST 3024-44 ~~open~~ F/oil Arb. 3306'  
TD 3310' 5" @ 3310 DD 3320'

S/8 BOPH 1000 A S/9 BOPH 2000 A  
S/12 BOPH Comp. 108 BOPD

COMPLETED



