


Map No. _____ Sec. 5 Twp. 31 R. 5Well No. 1-Haltby FarmHeberling et al. Company

NORTH

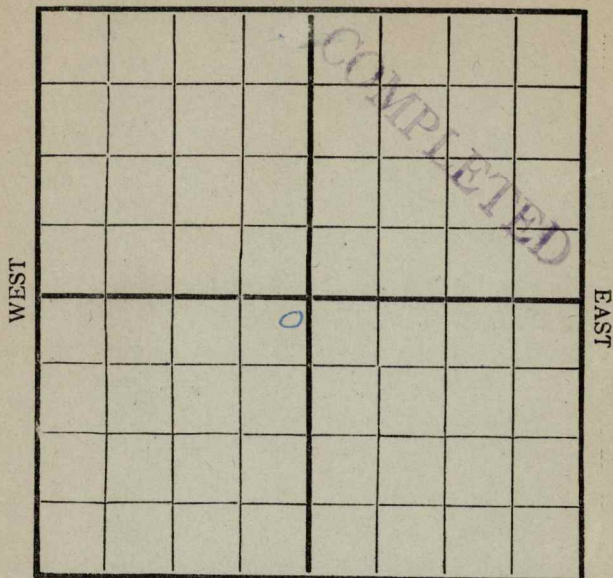

SOUTH

Location 19/21/16

Rig Up _____

Drilling Remarks:

Drilling Remarks:

10/28 - 680

RECORD

PRODUCTION

Cased _____ in _____ Ft.

1st 24 hrs. Nat. _____

Sand _____

1st 24 hrs. after shot _____

Gas _____

Gas None Cu. Ft.


Oil _____

Dry Hole ☒Total Depth 680Abandoned ☒

Map No. _____ Sec. 5 Twp. 31 R. 5
 Well No. 1 Naethy Farm
Heberling et al Company

NORTH

WEST

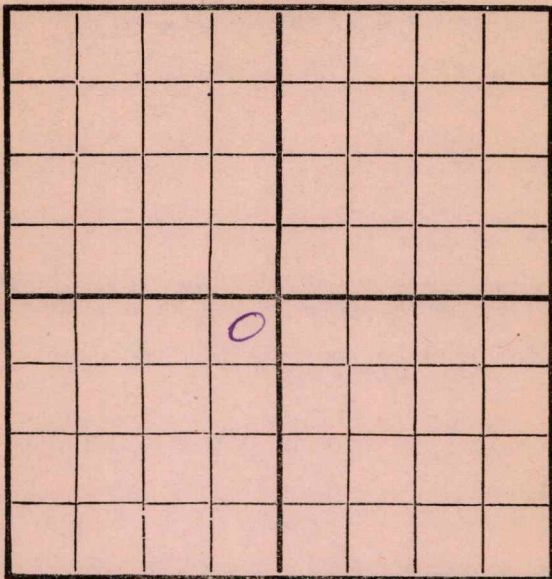

EAST

SOUTH

Location ☒

Rig Up _____

Drilling and remarks _____

RECORD

Cased _____ in. _____ Ft.

Sand _____

Gas _____

Oil _____

Total Depth _____

PRODUCTION

1st 24 hrs. Nat. _____

First 24 hrs. after shot _____

Gas _____ Cu. Ft.

Dry Hole _____

Abandoned _____

Date


10/14, 1916 E. Heberling Scout

Map No. Cowley Sec. 5 Twp. 31 R. 5Well No. #1 Holtby FarmHeberling et al Company

NORTH

WEST

EAST

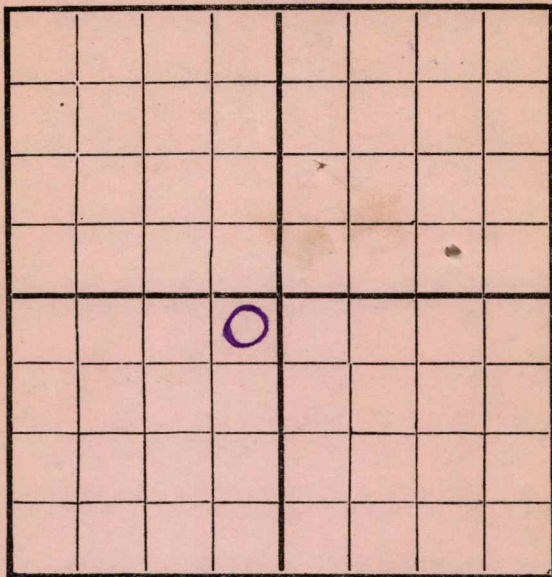

SOUTH

Location ✓

Rig Up

Drilling and remarks

Will move in Star Oil
machine to drill
shallow gas well

RECORD

Cased _____ in. _____ Ft.

Sand _____

Gas _____

Total Depth _____

PRODUCTION

1st 24 hrs. Nat. _____

1st 24 hrs. after shot _____

Gas _____ Cu. Ft.

Dry Hole _____

Abandoned _____

Date


10/11, 1916

Scout

COWLEYMap No. Sec. 5 Twp. 31 R. 5Well No. 1 Holtby Farm..... Heberling et al Company

NORTH

WEST

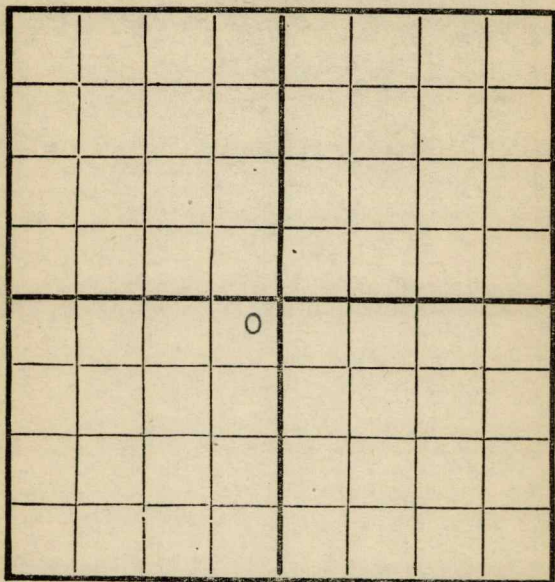

EAST

SOUTH

Location ✓

Rig Up

Drilling and remarks

Moving in mch.

RECORD

Cased in. Ft.

Sand

Gas

Oil

Total Depth

PRODUCTION

1st 24 hrs. Nat.

First 24 hrs. after shot

Gas Cu. Ft.

Dry Hole

Abandoned

Date

OCT 21 1916


191

E. H. WEST Scout

COWLEYMap No. _____ Sec. 5 Twp. 31 R. 5Well No. 1 Holtby Farm __________ Heberling et al Company

NORTH

WEST

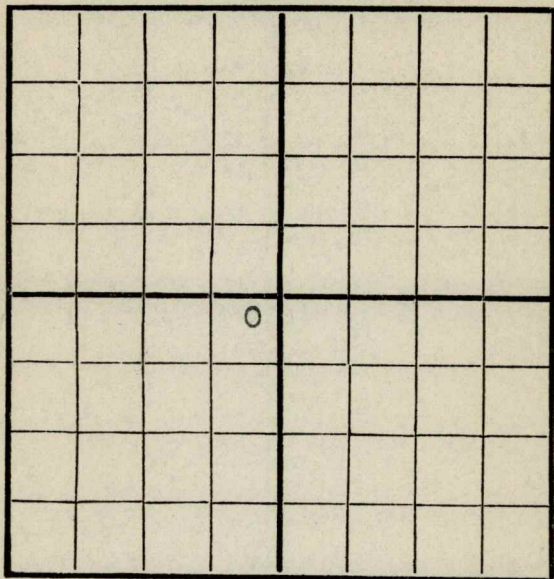

EAST

SOUTH

Location _____

Rig Up _____

Drilling and remarks

/ 680

RECORD

Cased _____ in. _____ Ft.

Sand _____

Gas _____

Oil _____

Total Depth _____

PRODUCTION

1st 24 hrs. Nat. _____

1st 24 hrs. after shot _____

Gas _____ Cu. Ft.

Dry Hole _____

Abandoned _____

Date

OCT 28 1916**E. H. WEST**

191

Scout


Cowley

Map No. _____ Sec. 5 Twp. 31 R. 5Well No. 1 Holtby _____ Farm

Heberling et al _____ Company

NORTH

WEST

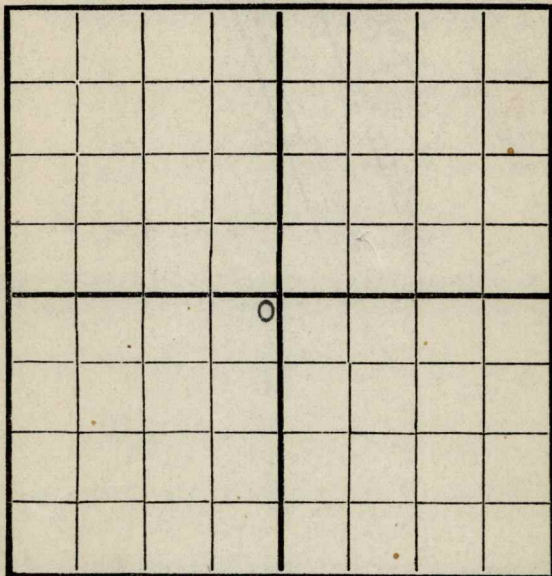

EAST

SOUTH

Location _____

Rig Up _____

Drilling and remarks _____

RECORD

Cased _____ in. _____ Ft.

Sand _____

Gas noneOil "Total Depth 680

PRODUCTION

1st 24 hrs. Nat. _____

1st 24 hrs. after shot _____

Gas _____ Cu. Ft.

Dry Hole ☒Abandoned ☒

Date

10/30, 1916, _____ Scout

COMPLETED