
FORM 51

Barton KANSAS

Section 15 Township 18 Range 11W

Well No. 5 ~ Drews "B"

Company Prugh Pet. Co.

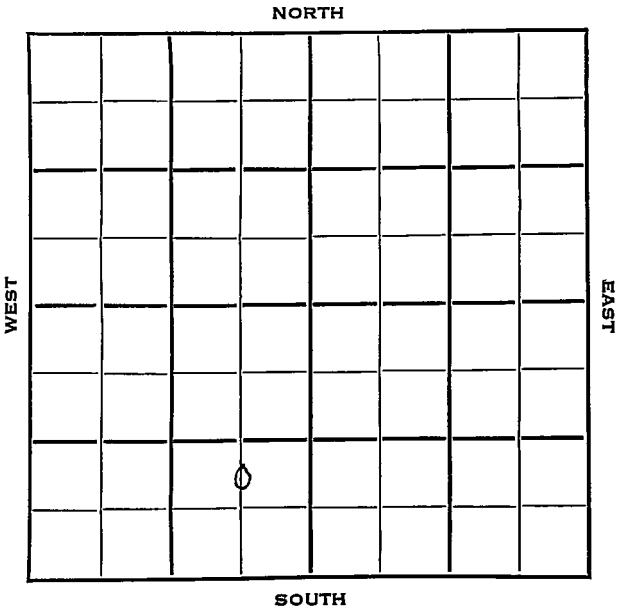

FORM 252-B
10M 8-51 TPCO.

Barton KANSAS ✓

Sec. 15 Twp. 18 R. 11 W

Well No. # 5 Drews "B" Farm

Prugh Pet. Co. Company

Garvie Contractor

Ames Pool


Ft. from N. Line

990 Ft. from S. Line

660 Ft. from E. Line

Ft. from W. Line

C N L SE SW

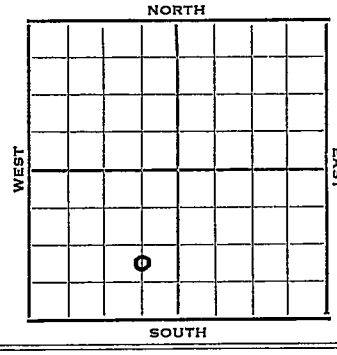

1953	Elev. 1786' REPORT
4/8	Spud 4-3-53 8" @ 267 Anhy 582' Drlg. 2053'
4/15	Spud 4-3-53 D&A TD 3386 8" @ 267 Anhy 582, ± Top 2650, DST 2850-61, opn 40 mins., rec. 6' mud, 230# Heeb 2909, Br lime 3021, Lans 3036 DST 3074-89, opn 1 hr., rec. 450' sw 580# DST 3114-31, opn 1 hr., rec. 68' sw, 760# DST 3264-90, opn 1 hr., rec. 3' mud, 28# B KC 3305, Cong 3315 TD 3386 D&A ABANDONED

FORM 275 FOR SALE BY KANSAS BLUE PRINT CO.


County Barton State Kansas

Sec. 15 (Blk. Twp.) 18 (Sur. Rge.) 11W Map No.

Operator Prugh Pet. Co.

Well No. 5 Farm Drews "B"

Elev. 1786 Location C N L SE SW

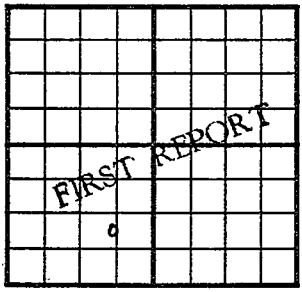

990 Ft. From S Line SW

660 Ft. From E Line Quarter

1st. Report APR 8 1953

Completion

Remarks

Garvie - Contr.

Spudding Date 4-3-53

Drlg. Data Ames Pool

8" @ 267 Anhy 582 drlg. 2053

J. G. McGEHEE

FORM 275 FOR SALE BY KANSAS BLUE PRINT CO.


County Barton State Kansas

Sec. 15 (Blk. Twp.) 18 (Sur. Rge.) 11W Map No.

Operator Prugh Pet.

Well No. 5 Farm Drews "B"

Elev. 1786 Location C N L SE SW

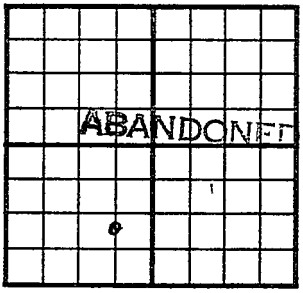

990 Ft. From S Line SW

660 Ft. From E Line Quarter

1st. Report

Completion APR 15 1953

Remarks Ames Pool
Garvie - Contr.

Spudding Date 4-3-53

Drlg. Data D & A TD 3386

8" @ 267 Anhy 582 Top. 2650

DST 2850-61 open 40 min. Rec. 6' mud

230# Heeb. 2909 Br. lime 3021

Lans. 3036 DST 3074-89 open 1 hr.

Rec. 450' sw 580# DST 3114-31

open 1 hr. Rec. 68' sw 760#

DST 3264-90 open 1 hr. Rec. 3' mud

28# B KC 3305 Cong. 3315 TD 3386

D & A

J. G. McGEHEE