FORM 51 10M 8-47


KANSAS

Barton

Section 15 Township 18 Range 11W

Well No. #1 Drew "C"

Company R. I. Williams

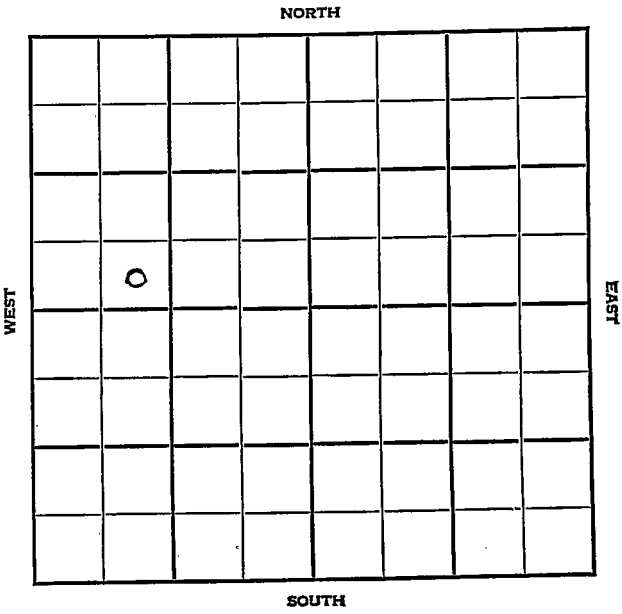

FORM 252-A
5M 9-47 PETROL

KANSAS Barton

Sec. 15 Twp. 18 R. 11-W

Well No. #1 Drew "C" Farm

R. L. Williams Company

Ames Pool


_____ Ft. from N. Line

330' Ft. from S. Line

_____ Ft. from E. Line

990' Ft. from W. Line

SE SW NW

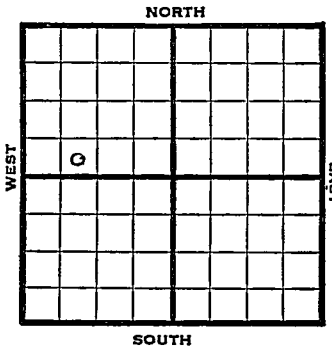

1947	Elev. 1786' REPORT
12/10	Loc.
12/30	Lans. 3043' Arb. 3347' TD 3377'

ABANDONED

Form 26 200 Bks. 10-46 Petrol

Ames Pool

Kansas

Map No. _____ Sec. 15 Twp. 18 R. 11W


Well No. 1 Drew "C"

R. L. Williams Company

FIRST REPORT Contractor

SE SW NW

SECTION PLAT

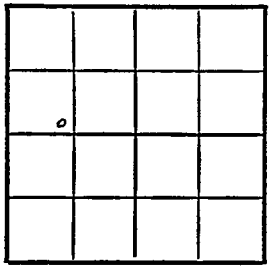

_____ Ft. from N. Line

330 Ft. from S. Line

_____ Ft. from E. Line

990 Ft. from W. Line

Barton County

Location X

Rig up _____

Drilling and Remarks:

RECORD

Cased _____ in., _____ ft.

Sand _____

Gas _____

Oil _____

Total Depth _____

PRODUCTION

1st 24 hrs. Nat. _____

1st 24 hrs. after shot _____

Gas _____ Cu. Ft.

Dry Hole _____

Abandoned _____

Date

DEC 1 0 1947 19 S. J. LEWIS Scout

Form 26 200 Bks. 10-46 Petrol

Ames Pool

Kansas

Map No. 55 Sec. 15 Twp. 18 R. 11W

Well No. 1 Drew "C"


R. L. Williams Company

ABANDONED Contractor

SE SW NW

E. 1986

SECTION PLAT

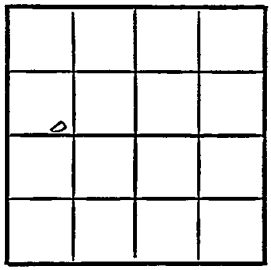

Ft. from N. Line

330 Ft. from S. Line

Ft. from E. Line

990 Ft. from W. Line

Barton County

Location

Rig up

Drilling and Remarks:

Lans 8943

Ref 33947

RECORD

Cased in., ft.

Sand

Gas

Oil

Total Depth 8977

PRODUCTION

1st 24 hrs. Nat.

1st 24 hrs. after shot

Gas Cu. Ft.

Dry Hole

Abandoned

Date

DEC 30 1947 19

S. I. LEWIS Scout