

Map No. _____ Sec. 9 Twp. 31 R. 5Well No. 1- Cole Farm _____Benedum & Trees Company _____

NORTH

WEST

EAST

SOUTH

Location _____

Rig Up Star Truck - 10/5/16

Drilling Remarks:

Drilling Remarks:

10/12/16 - Spudding
10/21 - 690

RECORD

PRODUCTION

Cased _____ in _____ Ft.

1st 24 hrs. Nat. _____

Sand _____

1st 24 hrs. after shot _____

Gas _____

Gas _____ Cu. Ft.

Oil _____

Dry Hole _____

Total Depth _____

Abandoned _____

Cowley

Map No. _____ Sec. 9 Twp. 31 R. 5Well No. #1 Cole Farm _____

Benedum & Trees Company

NORTH

WEST

EAST

SOUTH

Location ✓Rig Up Star mch

Drilling and remarks

RECORD

Cased _____ in. _____ Ft.

Sand _____

Gas _____

Oil _____

Total Depth _____

PRODUCTION

1st 24 hrs. Nat. _____

1st 24 hrs. after shot _____

Gas _____ Cu. Ft.

Dry Hole _____

Abandoned _____


Date

10/5, 1916Exwest

Scout

Cowley
Map No. _____ Sec. *9* Twp. *31* R. *5*
Well No. *1 Cole* Farm
Benedum & Treas Company

NORTH

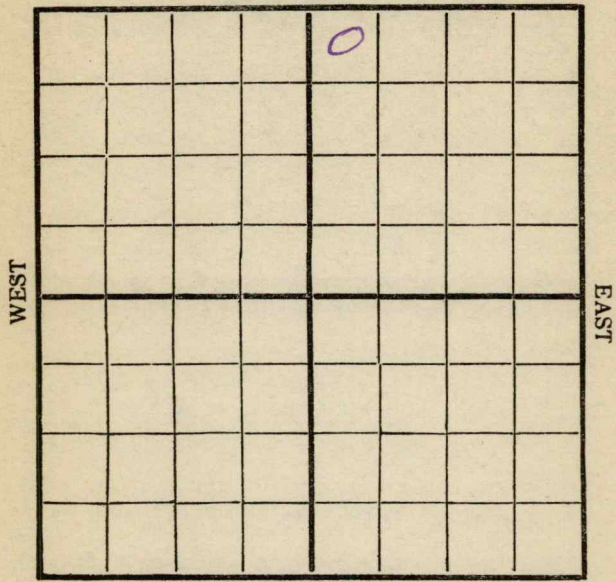

SOUTH

Location *✓*
Rig Up *Star mch.*
Drilling and remarks

RECORD

Cased _____ in. _____ Ft.
Sand _____
Gas _____
Oil _____
Total Depth _____

PRODUCTION


1st 24 hrs. Nat. _____
1st 24 hrs. after shot _____
Gas _____ Cu. Ft.
Dry Hole _____
Abandoned _____

Date *10/7*, 191*6* *E. Hewitt* Scout

Map No. _____ Sec. 9 Twp. 31 R. 5
 Well No. 1 Cole Farm _____
Benedict & Treas Company

NORTH

WEST

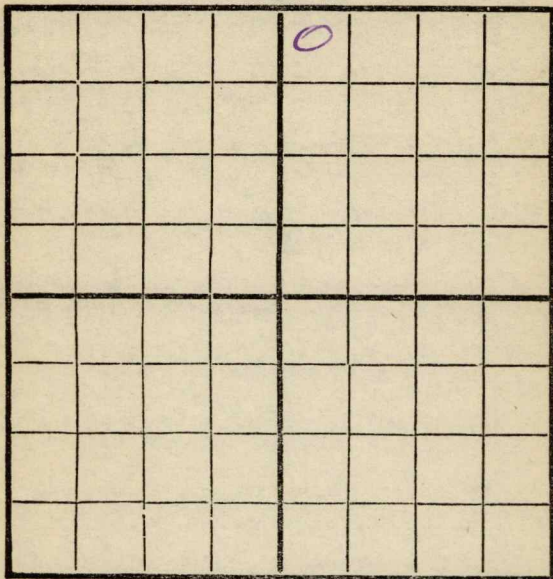

EAST

SOUTH

Location _____
 Rig Up _____
 Drilling and remarks _____

Spudding

RECORD

Cased _____ in. _____ Ft.
 Sand _____
 Gas _____
 Oil _____
 Total Depth _____

PRODUCTION

1st 24 hrs. Nat. _____
 First 24 hrs. after shot _____
 Gas _____ Cu. Ft.
 Dry Hole _____
 Abandoned _____

Date

10/14, 1916

E. Hart


Scout

COWLEYMap No. _____ Sec. 9 Twp. 31 R. 5Well No. #1 Cole Farm _____

Benedum & Trees Company

NORTH

WEST

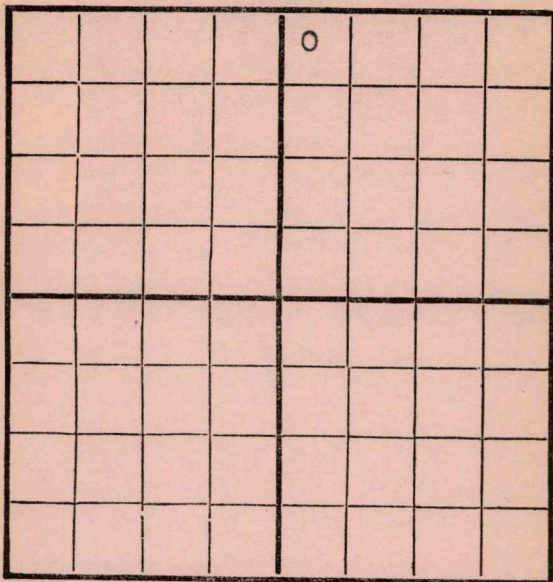

EAST

SOUTH

Location _____

Rig Up _____

Drilling and remarks

✓
690
missed the Elliott
gas sand so far

RECORD

Cased _____ in. _____ Ft.

Sand _____

Gas _____

Oil _____

Total Depth _____

PRODUCTION

1st 24 hrs. Nat. _____

First 24 hrs. after shot _____

Gas _____ Cu. Ft.

Dry Hole _____

Abandoned _____

Date

OCT 21 1916

191

E. H. WEST


Scout

Cowley

Map No. Sec. 9 Twp. 31 R. 5Well No. #1 Cole FarmBenedum & Trees Company

NORTH

WEST

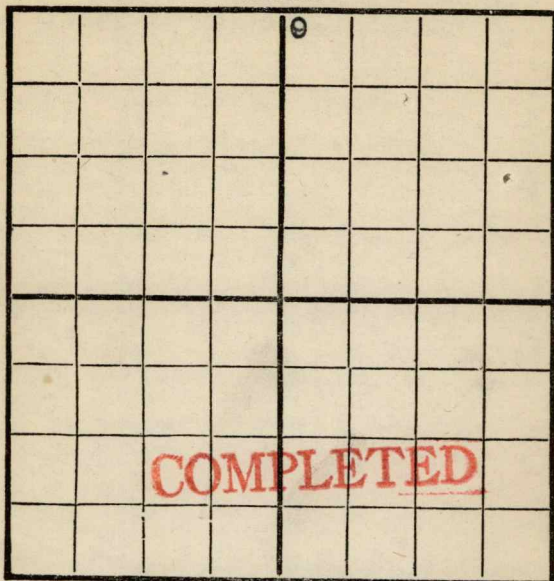

EAST

SOUTH

Location

Rig Up

Drilling and remarks

No showing of
gas or oil in
this hole at all.

RECORD

Cased in. Ft.

Sand 830-831Gas (water)

Oil

Total Depth 831

PRODUCTION

1st 24 hrs. Nat.

First 24 hrs. after shot

Gas Cu. Ft.

Dry Hole ☒Abandoned ☒

Date

10/23, 191 6

Scout