

Map No. _____ Sec. 9 Twp. 31 R. 5Well No. 4-Elliott Farm _____Heberling et al. Company _____

NORTH

WEST

EAST

SOUTH

COMPLETED

Location 1916Rig Up Star = 12-2-16

Drilling Remarks:

Drilling Remarks:

Spaulding = 12/9

RECORD

PRODUCTION

Cased _____ in _____ Ft.

1st 24 hrs. Nat. _____

Sand _____

1st 24 hrs. after shot _____

Gas _____

Gas _____ Cu. Ft.

Oil _____

Dry Hole _____

Total Depth _____


Abandoned _____

COWLEY

Map No. _____ Sec. 9 Twp. 31 R. 5Well No. 4 Elliott Farm _____Heberling et al Company

NORTH

WEST

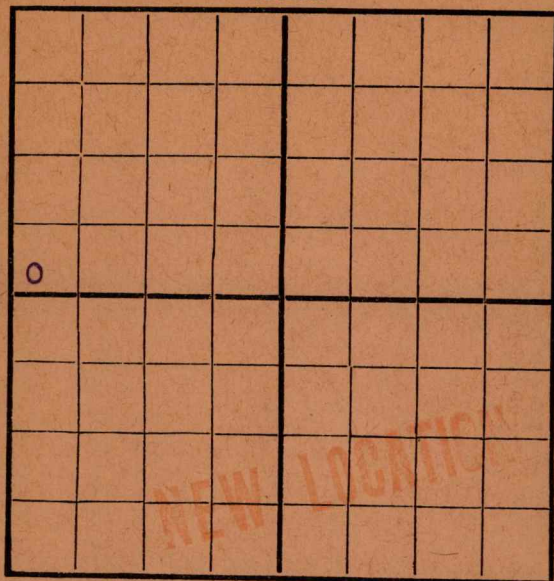

EAST

SOUTH

Location /Rig Up Star Mch

Drilling and remarks _____

RECORD

Cased _____ in. _____ Ft.

Sand _____

Gas _____

Oil _____

Total Depth _____

PRODUCTION

1st 24 hrs. Nat. _____

1st 24 hrs. after shot _____

Gas _____ Cu. Ft.

Dry Hole _____

Abandoned _____

Date _____

191

E. H. WEST

Scout

COWLEY

Map No. _____ Sec. 9 Twp. 31 R. 5


Well No. #4 Elliott Farm

Heberling et al Company

NORTH

WEST

EAST

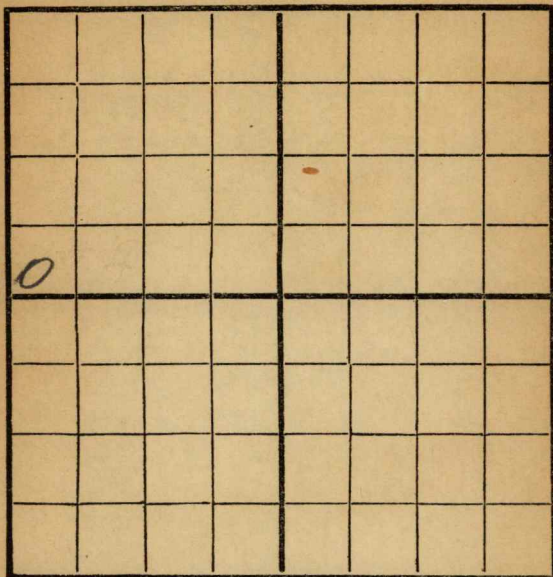

SOUTH

Location _____

Rig Up Star mech

Drilling and remarks

Spud

RECORD

Cased _____ in. _____ Ft.

Sand _____

Gas _____

Oil _____

Total Depth _____

PRODUCTION

1st 24 hrs. Nat. _____

1st 24 hrs. after shot _____

Gas _____ Cu. Ft.

Dry Hole _____

Abandoned _____

Date

DEC - 9 1916

E. H. WEST


191

Scout

COWLEY

Map No. _____ Sec. 9 Twp. 31 R. 5Well No. 4 Elliott FarmHeberling et al Company

NORTH

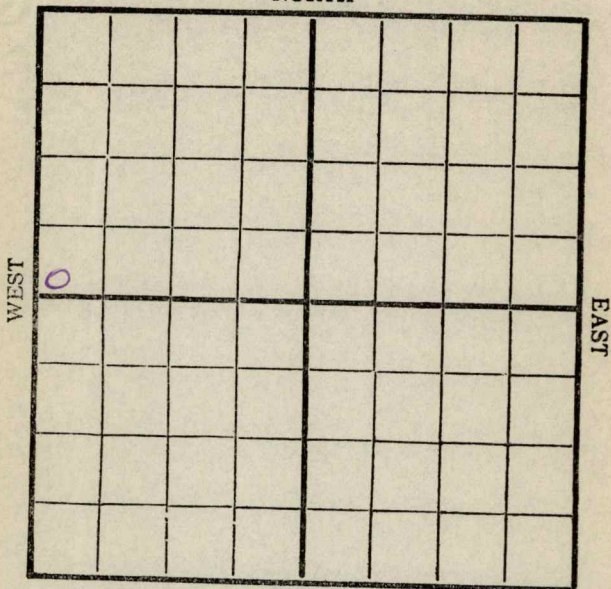

SOUTH

Location _____

Rig Up _____

Drilling and remarks

RECORD

Cased _____ in. _____ Ft.

Sand _____

Gas _____

Oil _____

Total Depth _____

PRODUCTION

1st 24 hrs. Nat. _____

1st 24 hrs. after shot _____

Gas _____ Cu. Ft.

Dry Hole _____

Abandoned _____

Date

DEC 16 1916

, 191

E. H. WEST

Scout

COWLEY

Map No. _____ Sec. 9 Twp. 31 R. 5Well No. 4 Elliott Farm _____Heberling et al Company _____

NORTH

WEST

0

EAST

COMPLETED

SOUTH

Location _____

Rig Up _____

Drilling and remarks _____

RECORD

Cased _____ in _____ Ft.

Sand _____

Gas _____

Oil _____

Total Depth 650

PRODUCTION

1st 24 hrs. Nat. _____

1st 24 hrs. after shot _____

Gas _____ Cu. Ft.

Dry Hole /Abandoned /

Date

DEC 20 1916

191

E. H. WEST Scout




Contractor

NORTH

WEST

EAST

SOUTH

Location _____

Rig up _____

Drilling and Remarks:

RECORD

Cased_____in., _____ft.

Sand_____

Gas _____

Oil _____

Total Depth_____

PRODUCTION

1st 24 hrs. Nat. -----

1st 24 hrs. after shot-----

Gas.....Cu. Ft.

Dry Hole

Abandoned.....

Date _____

191

Scout

400
Abandoned
650
12/20/11
Date 12/16 1916