


Section 16 Township 18 Range 11W

Well No. 1 Klapper-Feist

Company Derby et al

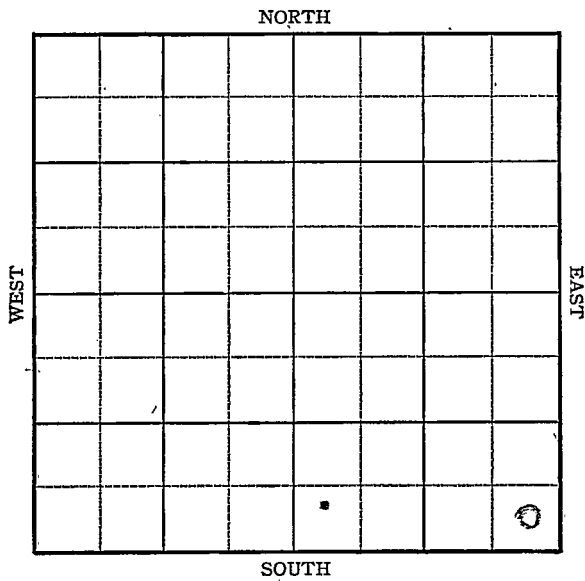

KANSAS

Barton County

Sec. 16 Twp. 18 R. 11WWell No. #1 Klapper-Feist FarmDerby et al Company

Ames

Ft. from N. Line

330


Ft. from S. Line

330

Ft. from E. Line

Ft. from W. Line

SE/c Elev. 1791

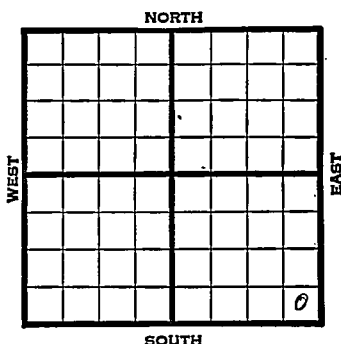

## REPORT

1945

7/11

Location

7/19

"

7/26

"

8/1

8" @ 237' WOC

8/8

Drlg. 2640

8/15

Lans 3042

Arb. 333

TD 3336

5" @ 3331' RUST

8/22

" " "

8/29

Drlg. 3338 no shows

9/5

TD 3352

500 acid.

Swab 17 $\frac{1}{2}$  oil 1 hr.

" " " "

9/12

9/19

Arb. 3331

5" @ 3331

1000 acid.

TD 3352'

Pump 100 oil plus 15 Wtr Pot.

Grav. 41.0

COMPLETED

KANSAS Kansas Pool Name AmesMap No. 55 Sec. 16 Twp. 18 R. 11WWell No. 1 Klapper-FeistDerby etal


Company

## FIRST REPORT

Contractor

SE/c

## SECTION PLAT

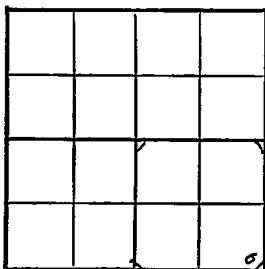       Ft. from N. Line330       Ft. from S. Line330       Ft. from E. Line       Ft. from W. LineBarton CountyLocation XRig up       

Drilling and Remarks:

## RECORD

Cased        in.,        ft.Sand       Gas       Oil       Total Depth       

## PRODUCTION

1st 24 hrs. Nat.       1st 24 hrs. after shot       Gas        Cu. Ft.Dry Hole       Abandoned       

Date

JUL 1 1 1945 19S. J. LEWIS

Scout

Pool Name Ames

KANSAS

KANSAS


Map No. 55 Sec. 16 Twp. 18 R. 11WWell No. 1 Klapper-FeistDerby etal

Company

COMPLETED

Contractor

SE/c

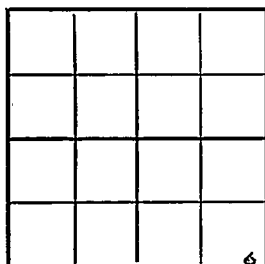E 11791  
SECTION PLAT

\_\_\_\_\_ Ft. from N. Line

330 Ft. from S. Line330 Ft. from E. Line

\_\_\_\_\_ Ft. from W. Line

Barton County

Location \_\_\_\_\_

Rig up \_\_\_\_\_

Drilling and Remarks:

*Ar 83331.**5" 83331**1000 acid**Pump 100 oil +  
15th Pt**4/2 Gr*

## RECORD

Cased \_\_\_\_\_ in., \_\_\_\_\_ ft.

Sand \_\_\_\_\_

Gas \_\_\_\_\_

Oil \_\_\_\_\_

Total Depth 3352

## PRODUCTION

1st 24 hrs. Nat. \_\_\_\_\_

1st 24 hrs. after shot \_\_\_\_\_

Gas \_\_\_\_\_ Cu. Ft.

Dry Hole \_\_\_\_\_

Abandoned \_\_\_\_\_

Date

SEP 1 9 1945 19

S. J. LEWIS

Scout