
FORM 51 IOM 12-46 PETROL KANSAS Barton

Section 16 Township 18 Range 11W

Well No. 2 Klepper

Company Derby et al
Ames

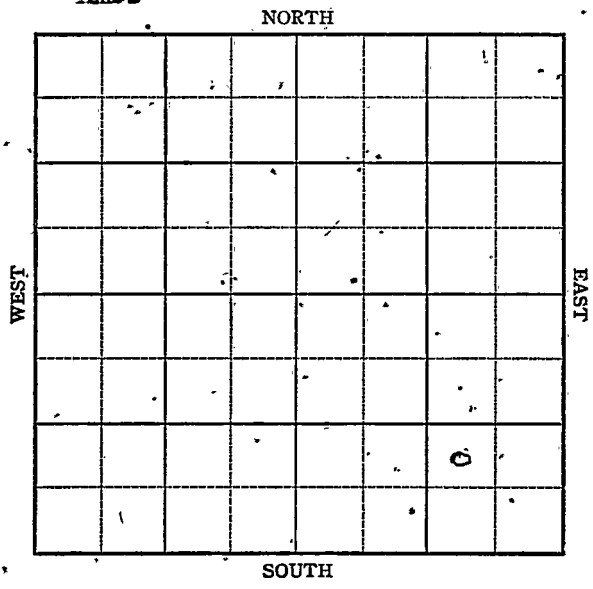

FORM 252-A
5M 6-46 PETROL

KANSAS Barton ✓

Sec. 16 Twp. 18 R. 11-W

Well No. #2 Klepper Farm

Derby etal Company


____ Ft. from N. Line

990 Ft. from S. Line

990 Ft. from E. Line

____ Ft. from W. Line

NW SE SE

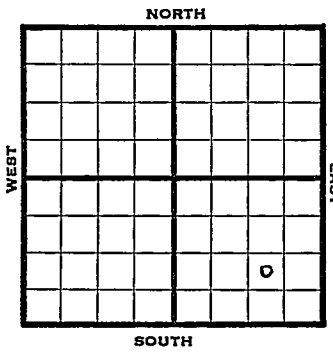

1947	Elev. 1796 REPORT
4/9	8" set 266' Drlg. 2020'
4/15	Lansing 3045' B KC 3309' Simpson 3826' Arbuckle 3337-43'TD - 5" @ 3338' RUST
4/23	" " "
4/29	500 Acid Swb 55 bbls oil PH 4 hrs
5/7	Arb 3337 5" @ 3338 500 Acid Pump 20 Pot TD 3343' Grav. 39

COMPLETED

Form 26 200 Bks. 10-46 Petrol KANSAS

Kansas

Ames Pool

Map No. 1535 Sec. 16 Twp. 18 R. 11W


Well No. 2 Klepper

Derby etal. Company

FIRST REPORT Contractor

NW SE SE

SECTION PLAT

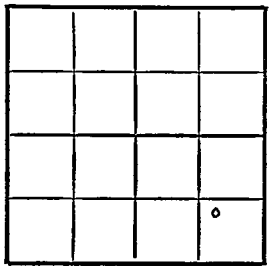

____ Ft. from N. Line

990 Ft. from S. Line

990 Ft. from E. Line

____ Ft. from W. Line

Barton County

Location

Rig up

Drilling and Remarks:

8" @ 266
drlg. 2020

RECORD

Cased ____ in., ____ ft.

Sand

Gas

Oil

Total Depth

PRODUCTION

1st 24 hrs. Nat.

1st 24 hrs. after shot

Gas ____ Cu. Ft.

Dry Hole

Abandoned

Date

APR 9 1947 19 S. J. LEWIS Scout

Form 26 200 Bks. 10-46 Petrol KANSAS Ames Pool

Kansas

Map No. K55 Sec. 16 Twp. 18 R. 11W

Well No. 2 Klepper

Derby etal. Company


COMPLETE

Contractor

NW SE SE

E.1.1796

SECTION PLAT

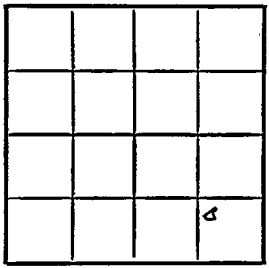

____ Ft. from N. Line

990 Ft. from S. Line

990 Ft. from E. Line

____ Ft. from W. Line

Barton County

Location

Rig up

Drilling and Remarks:

Cir 3332'
5" @ 3327'
500 cmt'd
Pump 20 Pot

RECORD

Cased ____ in., ____ ft.

Sand

Gas

Oil

Total Depth 3348

PRODUCTION

1st 24 hrs. Nat.

1st 24 hrs. after shot

Gas ____ Cu. Ft.

Dry Hole

Abandoned

Date

MAY 7 1947

19

S. J. LEWIS Scout