


Map No. _____ Sec. 10 Twp. 31 R. 5Well No. 1 Lewis FarmHeberling et al. Company

NORTH

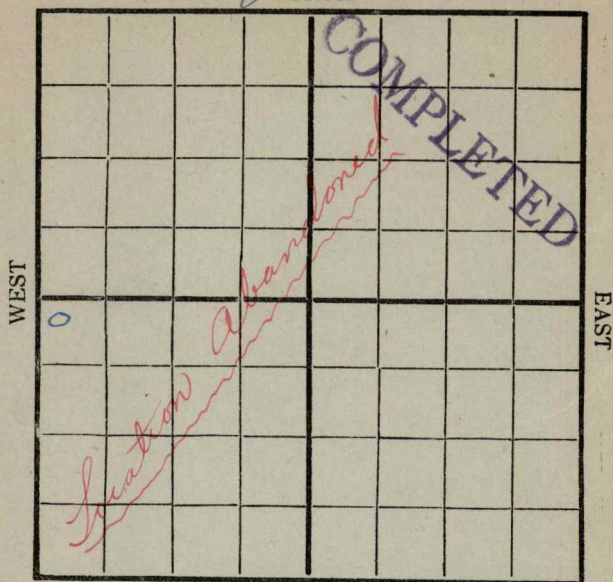

SOUTH

Location 10/21/16

Rig Up _____

Drilling Remarks:

Drilling Remarks:

Loc. 10/28-11/4-
Location abandoned

RECORD

PRODUCTION

Cased _____ in _____ Ft.

1st 24 hrs. Nat. _____

Sand _____

1st 24 hrs. after shot _____

Gas _____

Gas _____ Cu. Ft.

Oil _____


Dry Hole _____

Total Depth _____

Abandoned _____

Map No. Cowley Sec. 10 Twp. 31 R. 5
 Well No. #1 Lewis Farm
Heberling et al Company

NORTH

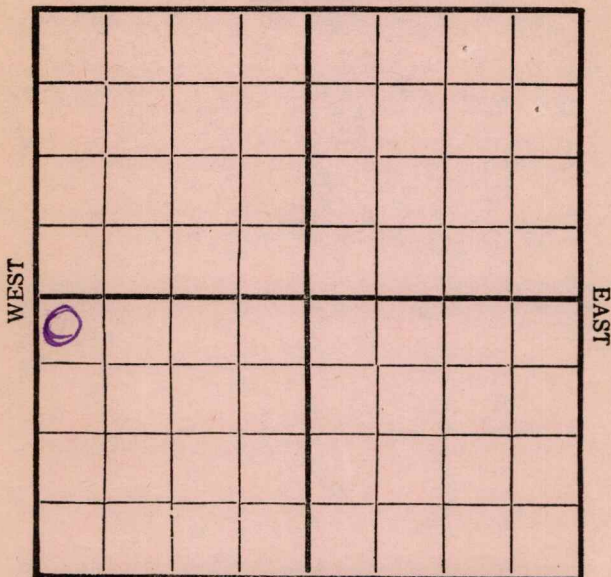

SOUTH

Location ✓

Rig Up

Drilling and remarks

To move in Star
 machine and drill
 shallow gas well.

RECORD

Cased _____ in. _____ Ft.

Sand _____

Gas _____

Oil _____

Total Depth _____

PRODUCTION

1st 24 hrs. Nat. _____

First 24 hrs. after shot _____

Gas _____ Cu. Ft.

Dry Hole _____

Abandoned _____

Date

10/13

191 6


Scout

Exhibit

Cowley
 Map No. _____ Sec. *10* Twp. *31* R. *5*
 Well No. *1 Lewis* Farm
Heberling et al Company

NORTH

WEST

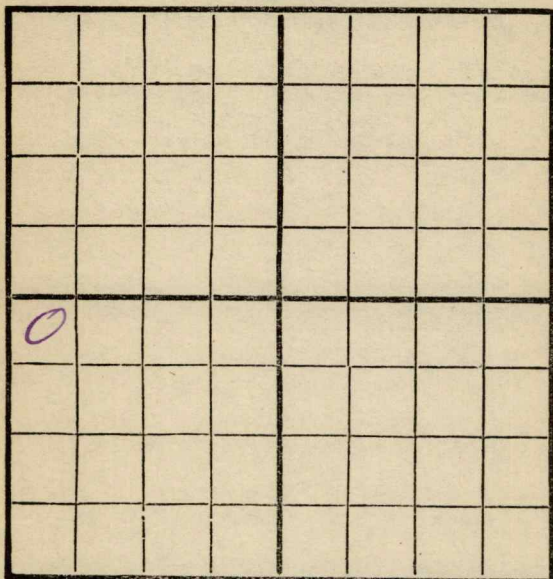

EAST

SOUTH

Location *✓*
 Rig Up _____
 Drilling and remarks _____

RECORD

Cased _____ in. _____ Ft.
 Sand _____
 Gas _____
 Oil _____
 Total Depth _____

PRODUCTION

1st 24 hrs. Nat. _____
 First 24 hrs. after shot _____
 Gas _____ Cu. Ft.
 Dry Hole _____
 Abandoned _____

Date

10/14, 191*6*


E. Hewitt

Scout

COWLEYMap No. Sec. 10 Twp. 31 R. 5Well No. 1 Lewis FarmHeberling et al Company

NORTH

WEST

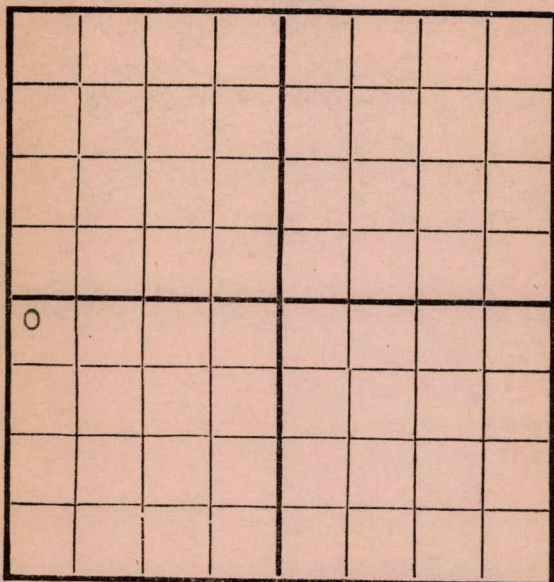

EAST

SOUTH

Location ✓Rig Up •

Drilling and remarks

RECORD

Cased in. Ft.

Sand

Gas

Oil

Total Depth

• PRODUCTION

1st 24 hrs. Nat.

First 24 hrs. after shot

Gas Cu. Ft.

Dry Hole

Abandoned

Date

OCT 21 1916

191


E. H. WEST

Scout

COWLEYMap No. _____ Sec. 10 Twp. 31 R. 5Well No. 1 Lewis Farm __________ Heberling et al company

NORTH

WEST

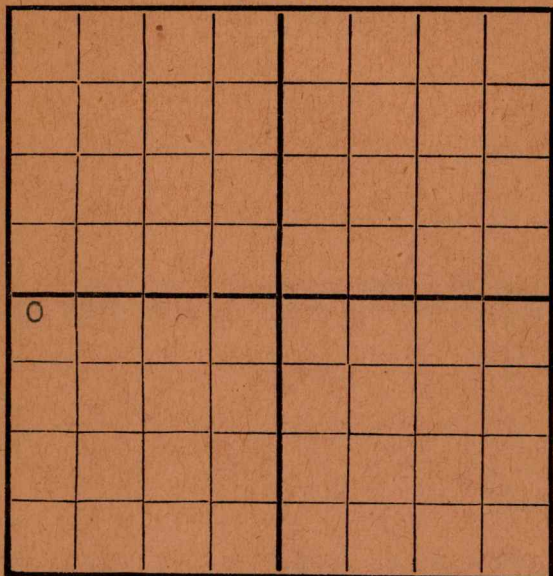

EAST

SOUTH

Location / _____

Rig Up _____

Drilling and remarks _____

RECORD

Cased _____ in. _____ Ft.

Sand _____

Gas _____

Oil _____

Total Depth _____

PRODUCTION

1st 24 hrs. Nat. _____

1st 24 hrs. after shot _____

Gas _____ Cu. Ft.

Dry Hole _____

Abandoned _____

Date

OCT 28 1916

191

E. H. WEST

Scout


COWLEY

Map No. _____ Sec. 10 Twp. 31 R. 5
 Well No. 1 Lewis Farm _____
 _____ Heberling et al Company

NORTH

WEST

EAST

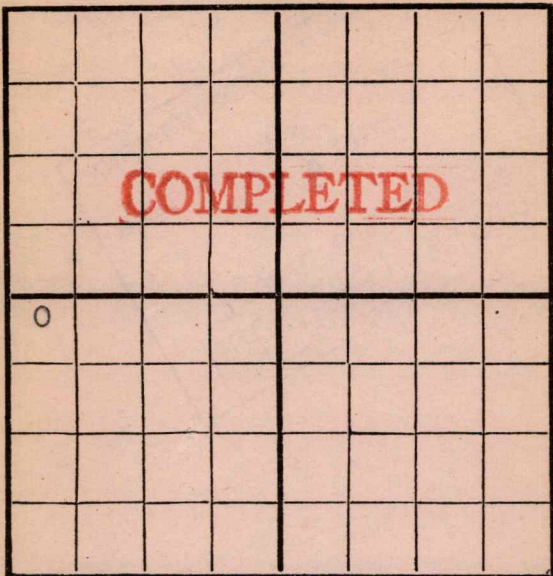

SOUTH

Location /
 Rig Up _____
 Drilling and remarks _____
 Location for
 shallow gas well
 abandoned account
 dry hole to north

RECORD

Cased _____ in. _____ Ft.
 Sand _____
 Gas _____
 Oil _____
 Total Depth _____

PRODUCTION

1st 24 hrs. Nat. _____
 1st 24 hrs. after shot _____
 Gas _____ Cu. Ft.
 Dry Hole _____
 Abandoned _____

Date

11/7, 1916

Scout


[Handwritten signature]

Map No. Cowley Sec. 10 Twp. 31 R. 5

Well No. 1 Lewis Farm
Heberling et al Company

NORTH

WEST

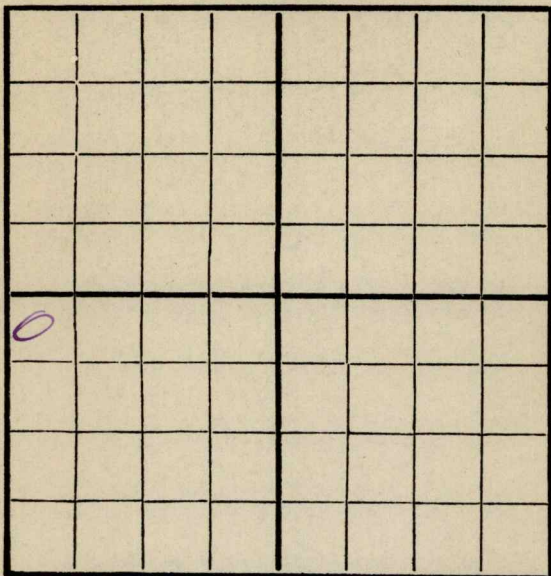

EAST

SOUTH

Location ✓

Rig Up

Drilling and remarks

RECORD

Cased _____ in. _____ Ft.

Sand _____

Gas _____

Oil _____

Total Depth _____

PRODUCTION

1st 24 hrs. Nat. _____

1st 24 hrs. after shot _____

Gas _____ Cu. Ft.

Dry Hole _____

Abandoned _____

Date

11/4, 1916, E. H. WEST Scout