


KANSAS Barton

FORM 51 IOM 12-46 PETROL

Section 16 Township 18 Range 11W

Well No. 4 Klepper

Company Derby et al

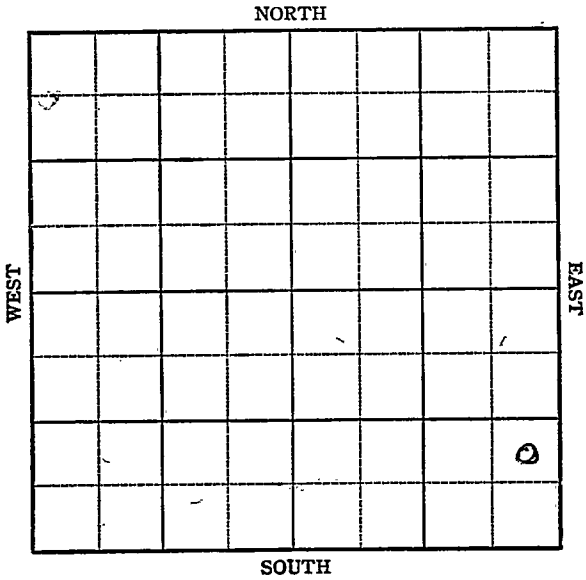

Sec. 16 Twp. 18 R. 11W

Well No. 4 Klepper Farm

Derby et al Company
Ames


 Ft. from N. Line

990 Ft. from S. Line

330 Ft. from E. Line

 Ft. from W. Line

NE SE SE

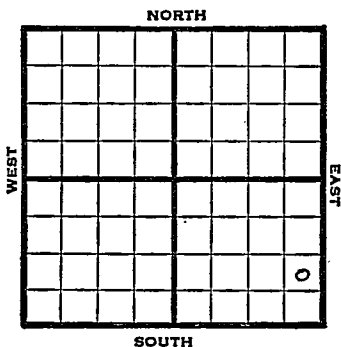

1947 Elev. 1794' REPORT

5/21 Location

5/27 8" @ 268'
WOC

6/3 Drlg 2250'

6/11 Arb. 3332'
5" @ 3333'
Lans. 3044'
Perf. Lans.
1000 Acid
Pump 200 Pot.
40.0 Gr.
TD 3335'

COMPLETED

Map No. 155 Sec. 16 Twp. 18 R. 11W

Well No. 4 Klepper

Derby etal. Company

FIRST REPORT Contractor

NE SE SE

SECTION PLAT

_____ Ft. from N. Line

990 Ft. from S. Line

330 Ft. from E. Line

_____ Ft. from W. Line

			o

Barton County

Location X

Rig up _____

Drilling and Remarks:

RECORD

Cased _____ in., _____ ft.

Sand _____

Gas _____

Oil _____

Total Depth _____

PRODUCTION

1st 24 hrs. Nat. _____

1st 24 hrs. after shot _____

Gas _____ Cu. Ft.

Dry Hole _____

Abandoned _____

Date

MAY 21 1947 19

S. J. LEWIS Scout

