


Section 15 Township 31 Range 5 E

Well No. # 1 Wadsack

Company Fortier & Wright

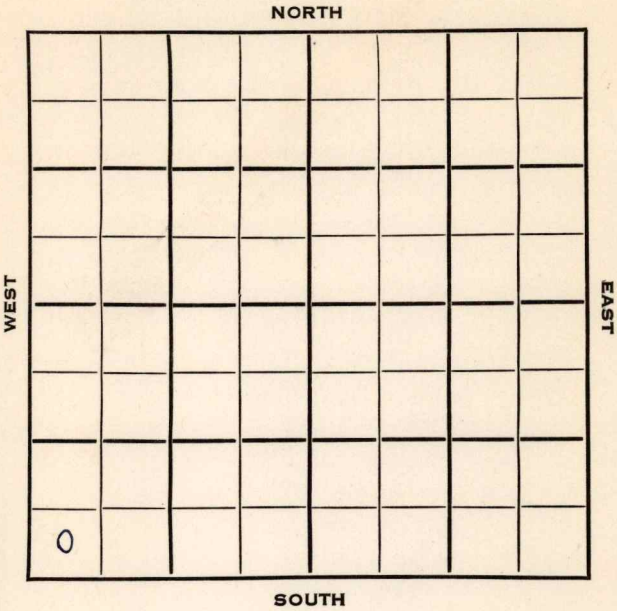

Cowley KANSAS

SEC. 15	TWP. 31	R. 5E ✓
---	---	---

WELL NO. FARM

1 Wadsack

COMPANY

Fortier & Wright

CONTRACTOR

Fortier & Wright


Wildcat

_____ Ft. from N. Line

330 _____ Ft. from S. Line

_____ Ft. from E. Line

330 _____ Ft. from W. Line

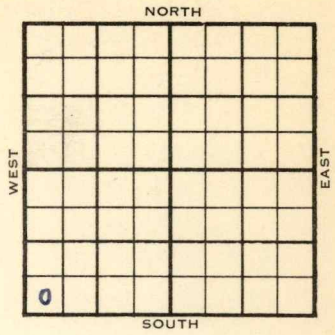

SW SW SW

1953	ELEVATION 1266'	REPORT
------	---	--------

12/2	Spud 11-25-53 8" @ 170' Drlg. 1485'
12/9	Spud 11-25-53 D&A TD 3030' 8" @ 170' Layton 2270', Miss 2977', VSSO TD 3030' D&A

ABANDONED

County **Cowley** State **Kansas**

Sec. 15 (Blk. Twp.) 31 (Sur. Rge.) 5E Map No.

Operator Fortier & Wright

Well No. 1 Farm Wadsack

Elev.	Location	SW SW SW

330 Ft. From S Line SW

330 Ft. From W Line Quarter

1st. Report DEC 2 1953

Completion

Remarks

Fortier & Wright - Contr.

Spudding Date 11-25-53

Drlg. Data Wildcat

8" @ 170 drlg. 1485

J. G. McGEHEE

County

Cowley

State

Kansas

Sec.

15

(Blk.)
(Twp.)

31

(Sur.)
(Rge.)

5E

Map No.

Operator

Fortier & Wright

Well No.

1

Farm

Wadsack

Elev.

1266

Location

SW SW SW

ABANDONED

330 Ft. From

S Line

SW

330 Ft. From

W Line

Quarter

1st. Report

Completion

DEC 9 1952

Remarks

Wildcat

Fortier & Wright - Contr.

Spudding Date

11-25-53

Drlg. Data

D & A

TD 3030

8" @ 170

Layton 2270

Miss. 2977

VSSO

TD 3030

D & A

D & A