

FORM 51 5M 6-46 PETROL

Misc.

NORTH

WEST

EAST

SOUTH

0

KANSAS

Cowley county

Sec. 16 Twp. 31 R. 5E

Well No. 1 Elliott Farm

Ward McGinnis et al

Company

Miscellaneous

990


Ft. from N. Line

Ft. from S. Line

990

Ft. from E. Line

Ft. from W. Line

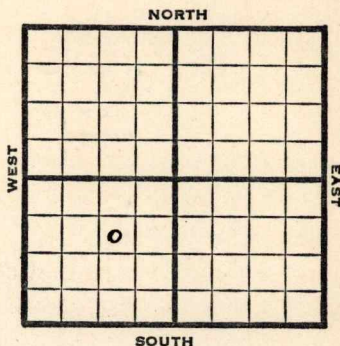

SW NE SW

1947

Elev. 122.1' REPORT

5/7 Location

5/13 "

5/20 "

5/27 "

6/3 "

6/10 "

6/17 15" @ 27'
Drlg. 280'

6/24 12" @ 452'
Drlg. 903'

7/1 Drlg 1395'
10" @ 1586'

7/8 8" @ 1682'
Drlg. 1720'

7/16 Drlg 1885'

7/22 8" @ 2035
Drlg. 2040

ER

1947

7/29 8" @ 2035'
Drlg 2040'

8/6 **Kansas City 2225'**
Drlg 2240'

8/13 6" @ 2235
Drlg. 2540

8/20 5" @ 2928'
Drlg 2958'

8/27 **Miss. 2928'**
Total Depth 3025'

ABANDONED

Map No. K2 Sec. 16 Twp. 31 R. 5E

Well No. 1 Elliott

Ward McGinnis et al. Company

FIRST REPORT

Contractor

SW NE SW


SECTION PLAT

990 Ft. from N. Line

Ft. from S. Line

990 Ft. from E. Line

Ft. from W. Line

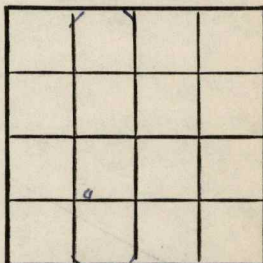

Cowley County

Location X

Rig up

Drilling and Remarks:

RECORD

Cased _____ in., _____ ft.

Sand _____

Gas _____

Oil _____

Total Depth _____

PRODUCTION

1st 24 hrs. Nat. _____

1st 24 hrs. after shot _____

Gas _____ Cu. Ft.

Dry Hole _____

Abandoned _____

Date

MAY 14 1947 19

S. J. LEWIS Scout

Map No. 2 Sec. 16 Twp. 31 R. 5E

Well No. 1 Elliott

Ward McGinnis et al. Company

ABANDONED

Contractor

SW NE SW

E1.1221
SECTION PLAT

990 Ft. from N. Line

 Ft. from S. Line

990 Ft. from E. Line

 Ft. from W. Line

Cowley County

Location

Rig up

Drilling and Remarks:

Miss 2928

RECORD

Cased in., ft.

Sand

Gas

Oil

Total Depth 3025

PRODUCTION

1st 24 hrs. Nat.

1st 24 hrs. after shot

Gas Cu. Ft.

Dry Hole

Abandoned

Date

AUG 27 1947 19 S. J. LEWIS Scout