

KANSAS

Rice

Form 51-5M-7-40-Palace


Section 7 Township 20 Range 10-W

Well No. #1 Wenke

Company Aladdin Petroleum et al

NORTH

Silica Pool

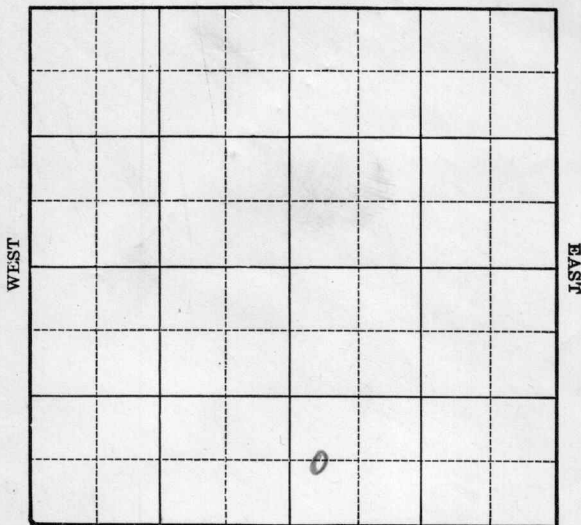

SOUTH

Map No. 46 Sec. 7 Twp. 20 R. 10W

Well No. 1 Wenke

Aladdin Petroleum etal Company

FIRST REPORT

Contractor

C W L SW SE

SECTION PLAT

 Ft. from N. Line

660 Ft. from S. Line

 Ft. from E. Line

330 Ft. from W. Line

		0	

SILICA POOL

Location

Rig up

Drilling and Remarks:

Derrick

RECORD

Cased in., ft.

Sand

Gas

Oil

Total Depth

PRODUCTION

1st 24 hrs. Nat.

1st 24 hrs. after shot

Gas Cu. Ft.

Dry Hole

Abandoned

Date

MAR 5 1941

19

S. J. LEWIS

Scout

Map No. 46 Sec. 7 Twp. 20 R. 10W

Well No. 1 Wenke

Aladdin Petroleum et al Company

ABANDONED

Contractor

SECTION PLAT

C W L SW SE

		o	

_____ Ft. from N. Line

660 Ft. from S. Line

_____ Ft. from E. Line

330 Ft. from W. Line

SILICA POOL

Location _____

Rig up _____

Drilling and Remarks:

Cor & 3382

No shows.

RECORD

Cased _____ in., _____ ft.

Sand _____

Gas _____

Oil _____

Total Depth 3487

PRODUCTION

1st 24 hrs. Nat. _____

1st 24 hrs. after shot _____

Gas _____ Cu. Ft.

Dry Hole _____

Abandoned _____

Date

APR 2 1941 19

S. J. LEWIS Scout