


KANSAS

Barton County

Section 16 Township 18 Range 11W

Well No. #1 Lieble

Company Bridgeport

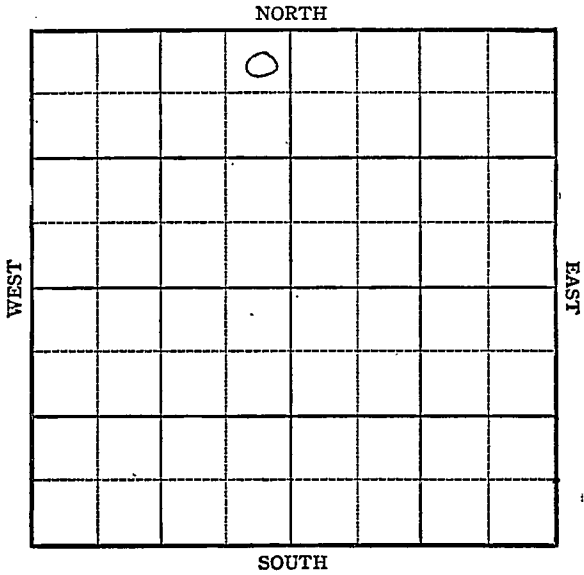

Sec. 16 Twp. 18 R. 11W

Well No. #1 Lieble Farm

Bridgeport Company


Wildcat

330 Ft. from N. Line

_____ Ft. from S. Line

330 Ft. from E. Line

_____ Ft. from W. Line

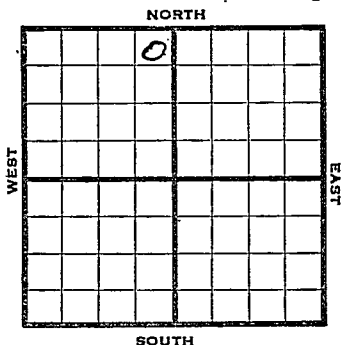

NE NW

1944

R E P O R T

10/18

Location

10/25

8" @ 254 Drlg. 1410

11/2

Topoka 2685

B. Oread 3017

Lans 3071

3133 fsg.

11/8

Lans 3070

TD 3133

Lost Hole

ABANDONED

KANSAS

Pool Name Wildcat

Map No. 55 Sec. 16 Twp. 18 R. 11W

Well No. 1 Lieble

Bridgeport Company

FIRST REPORT

Contractor

NE NW

SECTION PLAT

330 Ft. from N. Line

_____ Ft. from S. Line

330 Ft. from E. Line

_____ Ft. from W. Line

		o	

Barton County

Location X

Rig up _____

Drilling and Remarks:

RECORD

Cased _____ in., _____ ft.

Sand _____

Gas _____

Oil _____

Total Depth _____

PRODUCTION

1st 24 hrs. Nat. _____

1st 24 hrs. after shot _____

Gas _____ Cu. Ft.

Dry Hole _____

Abandoned _____

Date

OCT 1 8 1944 19

S. I. LEWIS Scout

Pool Name WildcatMap No. 55 Sec. 16 Twp. 18 R. 11WWell No. 1 LiehleBridgeport Company

ABANDONED

Contractor

NE NW

SECTION PLAT

330 Ft. from N. Line

_____ Ft. from S. Line

330 Ft. from E. Line

_____ Ft. from W. Line

		0	

Barton

Location _____

Rig up _____

Drilling and Remarks:

*Law 3078**Lost Hole*

RECORD

Cased _____ in., _____ ft.

Sand _____

Gas _____

Oil _____

Total Depth 3123

PRODUCTION

1st 24 hrs. Nat. _____

1st 24 hrs. after shot _____

Gas _____ Cu. Ft.

Dry Hole _____

Abandoned _____

Date

NOV 8 1944 19S. J. LEWIS Scout