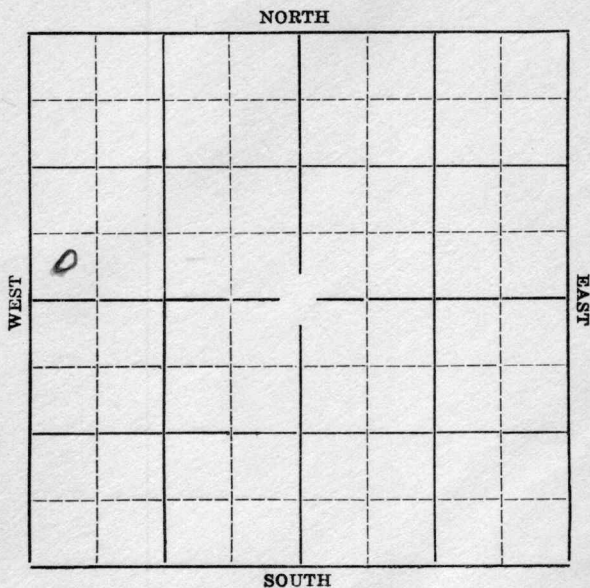
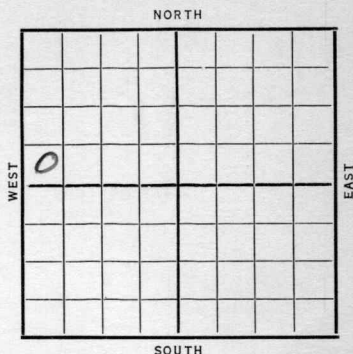


Section 6 Township 20 Range 10-WWell Number #14-BerscheidtCompany Tatlock

Sec. 6 Twp. 20 R. 10WWell No. #14 Berscheidt Farm
Tatlock Company Ft. from N. Line330' Ft. from S. Line Ft. from E. Line330' Ft. from W. LineElev. 1772

Date

REPORT

1936

10/7 Location.

10/15 Building rig.

10/22 12" @ 114'. Drlg. 500'.

10/29 Drlg. 2434'.

11/6 Sil. 3264 6" @ 3265 Rust

11/12----

11/19 Waiting on tanks.

11/27 T. D. 3267'. No test.

12/3 3272½', 2000' oil in hole.

12/9 Sil. 3264

Pot. 953

Nat. T.D. 3272½'

COMPLETED

KANSAS

Map No. 46 Sec. 6 Twp. 20 R. 10W

Well No. 14 Berscheid

Hallock Company

Contractor

SECTION PLAT

0			

 Ft. from N. Line

330 Ft. from S. Line

 Ft. from E. Line

330 Ft. from W. Line

FIRST REPORT

Location ✓

Rig up

Drilling and Remarks:

RECORD

Cased in., ft.

Sand

Gas

Oil

Total Depth

PRODUCTION

1st 24 hrs. Nat.

1st 24 hrs. after shot

Gas Cu. Ft.

Dry Hole

Abandoned

Date

OCT 7 1936 19

S. J. LEWIS


Scout

KANSAS

Map No. 46 Sec. 6 Twp. 20 R. 10WWell No. 14 BerscheidtJ. H. Tatrock. Company

Contractor

SECTION PLAT

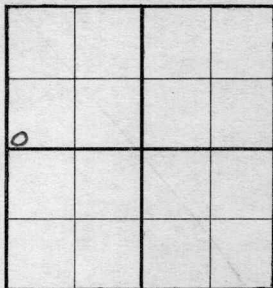

_____ Ft. from N. Line

330 Ft. from S. Line

_____ Ft. from E. Line

330 Ft. from W. Line

COMPLETED

RECORD

Location _____

Cased _____ in., _____ ft.

Rig up _____

Sand _____

Drilling and Remarks:

Gas _____

Oil _____

Total Depth 3272 1/2

PRODUCTION

1st 24 hrs. Nat. _____

1st 24 hrs. after shot _____

Gas _____ Cu. Ft.

Dry Hole _____

Abandoned _____

Date

DEC 9 1936

S. J. LEWIS

Scout