

Barton


FORM 51 IOM 12-46 PETROL

KANSAS

Section 16 Township 18 Range 11W

Well No. 3 Klepper

Company Derby et al

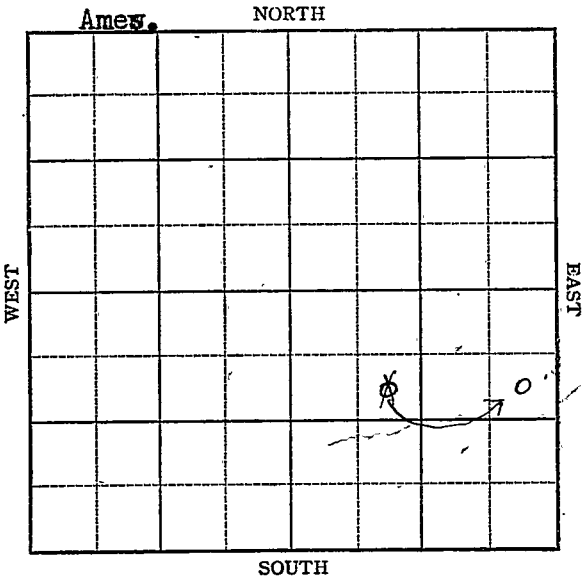

KANSAS

Barton

Sec. 16 Twp. 18 R. 11-W


Well No. #3 Klepper Farm  
Derby et al Company  
Ames Pool

990 Ft. from N. Line

Ft. from S. Line

330 Ft. from E. Line

~~990~~ Ft. from W. Line

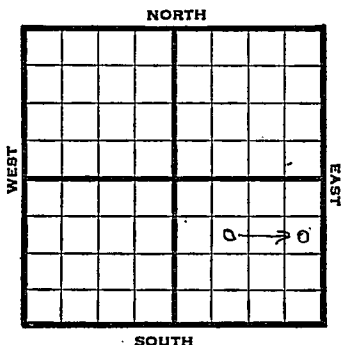

~~SE NE SE~~ SE NE SE

1947 Elev. 1796' REPORT

4/30 Location

5/7 8" @ 263'  
WOC

5/13 Lansing 3046'  
Drlg. 3084'

5/20 Arb 3338-41  
TD 3341'  
5" @ 3338'  
RUST

5/27 32 shots 3110-19'  
Flow 18 oil PH 3 hrs.

6/3 " " "

6/10 " " "

6/18 Arb. 3338'  
5" @ 3338'  
1000 Acid  
Pump 200 Pot.  
41.0 Gr.  
TD 3341'

COMPLETED





Map No. 55 Sec. 16 Twp. 18 R. 11W

Well No. 3 Klepper

Derby et al. Company

**COMPLETE** Contractor

SE NE SE

*E11792*  
SECTION PLAT

990 Ft. from N. Line

         Ft. from S. Line

330 Ft. from E. Line

         Ft. from W. Line

			o

Barton County

Location                                 

Rig up                                 

Drilling and Remarks:

*2 1/2 x 3338*  
*5" @ 3338.*  
*1000 acid*  
*Pump 200 ft*  
*H1944*

RECORD

Cased          in.,          ft.

Sand                                 

Gas                                 

Oil                                 

Total Depth 3341

PRODUCTION

1st 24 hrs. Nat.                         

1st 24 hrs. after shot                         

Gas                          Cu. Ft.

Dry Hole                         

Abandoned                         

Date

JUN 1 8 1947 19

S. J. LEWIS

Scout