

Rice


KANSAS

Form 51-5M-12-36 Com'l

Section 6 Township 20 Range 10-W

Well Number 16 Specht

Company Stanolind

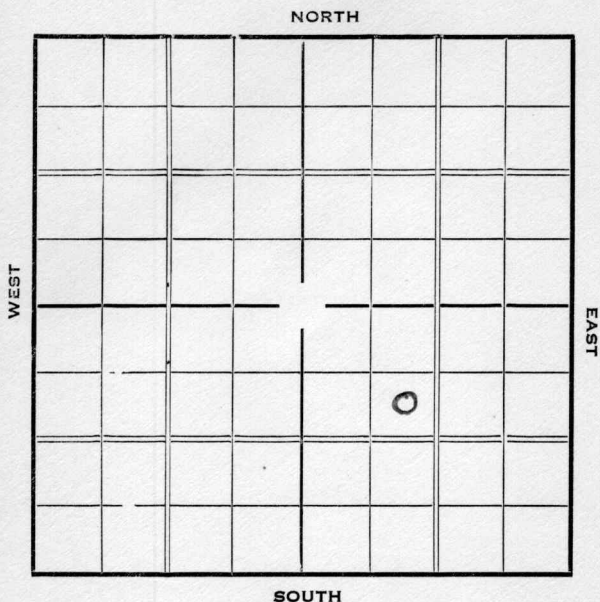

KANSAS *Rice*Map No. _____ Sec. 6 Twp. 20 R. 10WWell No. 16 SpechtStan & Lind Company

Contractor

SECTION PLAT

990 Ft. from N. Line

_____ Ft. from S. Line

_____ Ft. from E. Line

990 Ft. from W. Line

FIRST REPORT

Location ✓

Rig up _____

Drilling and Remarks:

RECORD

Cased _____ in., _____ ft.

Sand _____

Gas _____

Oil _____

Total Depth _____

PRODUCTION

1st 24 hrs. Nat. _____

1st 24 hrs. after shot _____

Gas _____ Cu. Ft.

Dry Hole _____

Abandoned _____

Date

APR 14 1937

S. J. LEWIS

Scout

Rice KANSAS

Map No. _____ Sec. 6 Twp. 20 R. 10^WWell No. 16 SpechtStanolind Company

Contractor _____

COMPLETED

990 Ft. from N. Line

_____ Ft. from S. Line

_____ Ft. from E. Line

990 Ft. from W. Line

SECTION PLAT

		0	

Location _____

Rig up _____

Drilling and Remarks:

2000 AcidRot 2146Based on 6 hr. Tests

RECORD

Cased 6 in., 3304 ft.Sand 511 3304

Gas _____

Oil _____

Total Depth 3310

PRODUCTION

1st 24 hrs. Nat. _____

1st 24 hrs. after shot _____

Gas _____ Cu. Ft.

Dry Hole _____

Abandoned _____

Date

MAY 26 1937 19

H. D. Hatfield

Scout