


Map No. _____ Sec. 15 Twp. 31 R. 5Well No. 1 Cochran Farm
Benedict & Trees Company

NORTH

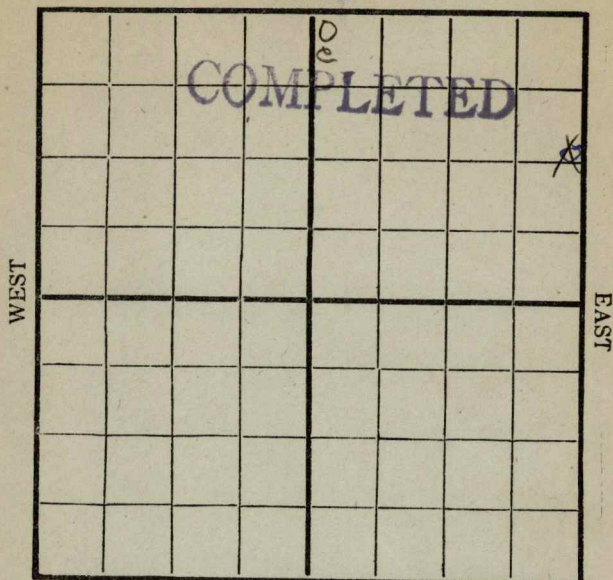

SOUTH

Location 11/11/16

Drilling Remarks:

Q. 2 1/2" = 11/25 = 12/2
Spudling = 12/9
550 = 12/23
800 = 12/30 = 1/6
1050 = 1/13
1350 = 1/20

Rig Up 11-18-16

Drilling Remarks:

RECORD

Cased _____ in _____ Ft.
 Sand _____
 Gas _____
 Oil _____
 Total Depth _____

PRODUCTION


1st 24 hrs. Nat. _____
 1st 24 hrs. after shot _____
 Gas _____ Cu. Ft.
 Dry Hole _____
 Abandoned _____

COWLEYMap No. Sec. 15 Twp. 31 R. 5Well No. 1 Cochran FarmBenedum & Trees Company

NORTH

WEST

EAST

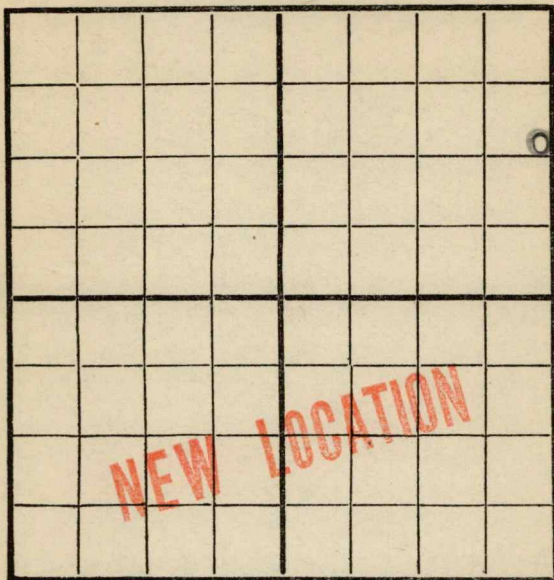

SOUTH

Location /

Rig Up

Drilling and remarks

Moving in timbers
for deep test

RECORD

Cased in. Ft.

Sand

Gas

Oil

Total Depth

PRODUCTION

1st 24 hrs. Nat.

1st 24 hrs. after shot

Gas Cu. Ft.

Dry Hole

Abandoned

Date

NOV 11 1916

191

E. H. WEST

Scout

COWLEY
 Map No. _____ Sec. 15 Twp. 31 R. 5
 Well No. 1 Cochran Farm _____
 _____ Benedum & Trees Company

NORTH

WEST

EAST

SOUTH

Location _____
 Rig Up _____ /
 Drilling and remarks _____

RECORD

Cased _____ in. _____ Ft.
 Sand _____
 Gas _____
 Oil _____
 Total Depth _____

PRODUCTION

1st 24 hrs. Nat. _____
 1st 24 hrs. after shot _____
 Gas _____ Cu. Ft.
 Dry Hole _____
 Abandoned _____

Date

NOV 18 1916

E. H. WEST

Scout

COWLEY

Map No. _____ Sec. **15** Twp. **31** R. **5**

Well No. **1** **Cochran** Farm

Benedum & Trees Company

NORTH

							0

WEST

EAST

SOUTH

Location _____
 Rig Up _____
 Drilling and remarks _____

RECORD

Cased _____ in. _____ Ft.
 Sand _____
 Gas _____
 Oil _____
 Total Depth _____

PRODUCTION

1st 24 hrs. Nat. _____
 1st 24 hrs. after shot _____
 Gas _____ Cu. Ft.
 Dry Hole _____
 Abandoned _____

Date **NOV 25 1916**

_____, 191____ **E. H. WEST** Scout


COWLEY

Map No. _____ Sec. 15 Twp. 31 R. 5Well No. 1 Cochran Farm _____

Benedum & Trees Company

NORTH

WEST

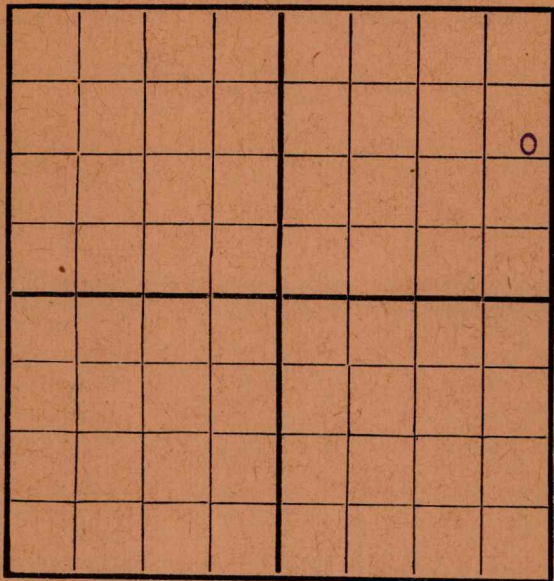

EAST

SOUTH

Location _____

Rig Up _____

Drilling and remarks

Rigging up

RECORD

Cased _____ in. _____ Ft.

Sand _____

Gas _____

Oil _____

Total Depth _____

PRODUCTION

1st 24 hrs. Nat. _____

1st 24 hrs. after shot _____

Gas _____ Cu. Ft.

Dry Hole _____

Abandoned _____

Date

DEC - 2, 1916

191

E. H. WEST

Scout

COWLEY

Map No. _____ Sec. 15 Twp. 31 R. 5


Well No. 1 Cochran Farm _____

B + J Company _____

NORTH

WEST

EAST

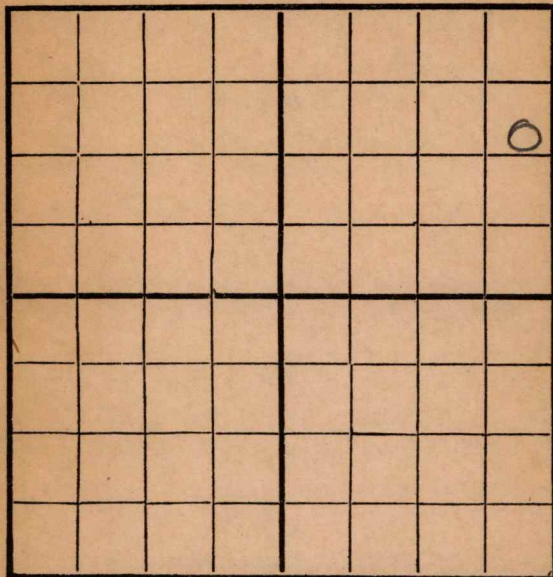

SOUTH

Location _____

Rig Up _____

Drilling and remarks

Spud

RECORD

Cased _____ in. _____ Ft.

Sand _____

Gas _____

Oil _____

Total Depth _____

PRODUCTION

1st 24 hrs. Nat. _____

1st 24 hrs. after shot _____

Gas _____ Cu. Ft.

Dry Hole _____

Abandoned _____

Date

DEC - 9 1916

E. H. WEST

_____, 191____ Scout

COWLEY

Map No. _____ Sec. 15 Twp. 31 R. 5


Well No. 1 Cochran Farm _____

B+2 Company _____

NORTH

WEST

EAST

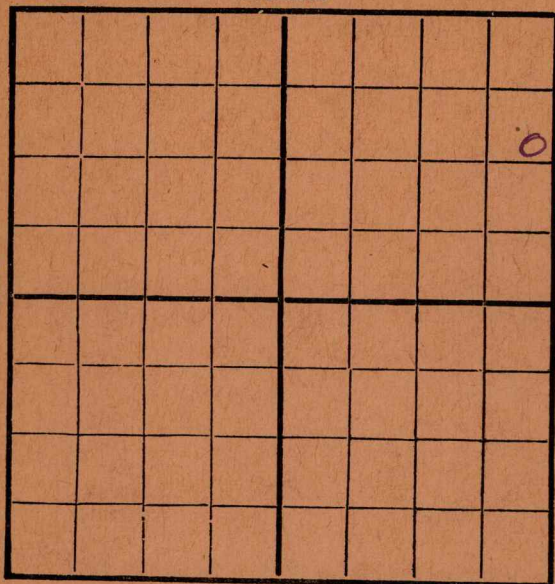

SOUTH

Location _____

Rig Up _____

Drilling and remarks

✓
200

RECORD

Cased _____ in. _____ Ft.

Sand _____

Gas _____

Oil _____

Total Depth _____

PRODUCTION

1st 24 hrs. Nat. _____

1st 24 hrs. after shot _____

Gas _____ Cu. Ft.

Dry Hole _____

Abandoned _____

Date DEC 16 1916

E. H. WEST

191


Scout

COWLEYMap No. _____ Sec. 15 Twp. 31 R. 5Well No. 1 Cochran Farm _____
B & J Company _____

NORTH

WEST

EAST

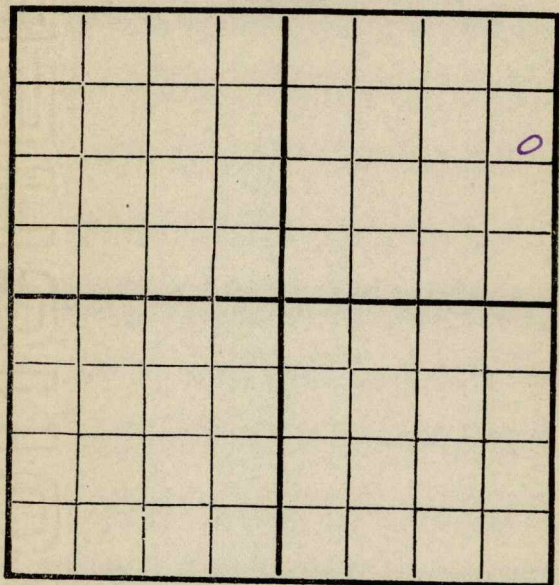

SOUTH

Location _____

Rig Up _____

Drilling and remarks

550 N.F. Water**RECORD**

Cased _____ in. _____ Ft.

Sand _____

Gas _____

Oil _____

Total Depth _____

PRODUCTION

1st 24 hrs. Nat. _____

1st 24 hrs. after shot _____

Gas _____ Cu. Ft.

Dry Hole _____

Abandoned _____

Date

DEC 23 1916

, 191 _____

E. H. WEST Scout

COWLEY

Map No. _____ Sec. 15 Twp. 31 R. 5Well No. 1 Cochran FarmB & J Company

NORTH

							<u>0</u>

WEST

EAST

SOUTH

Location _____

Rig Up _____

Drilling and remarks

800

RECORD

Cased _____ in. _____ Ft.

Sand _____

Gas _____

Oil _____

Total Depth _____

PRODUCTION

1st 24 hrs. Nat. _____

1st 24 hrs. after shot _____

Gas _____ Cu. Ft.

Dry Hole _____

Abandoned _____

Date

DEC 30 1916

191

E. H. WEST


Scout

COWLEY

Map No. _____ Sec. 15 Twp. 31 R. 5Well No. 1 Cochran Farm _____B+J

Company _____

NORTH

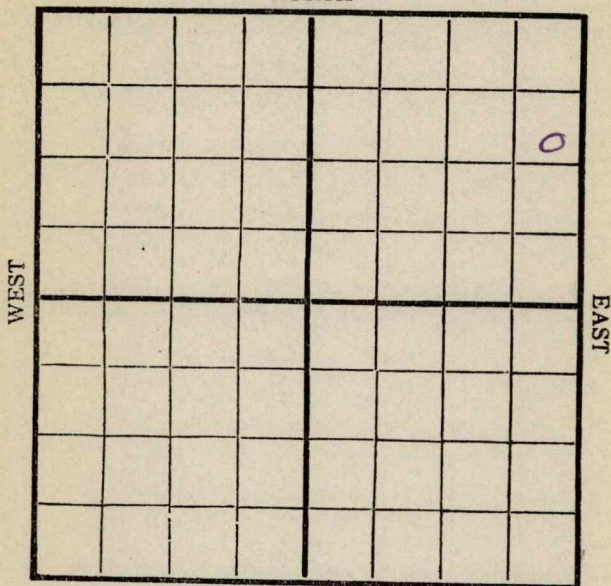

SOUTH

Location _____

Rig Up _____

Drilling and remarks

Casing 12 1/2 - 800

RECORD

Cased _____ in. _____ Ft.

Sand _____

Gas _____

Oil _____

Total Depth _____

PRODUCTION

1st 24 hrs. Nat. _____

1st 24 hrs. after shot _____

Gas _____ Cu. Ft.

Dry Hole _____

Abandoned _____

Date

JAN - 6 1917

, 191

E. H. WEST Scout


COWLEY

Map No. _____ Sec. 15 Twp. 31 R. 5Well No. 1 Cochran Farm __________B + J Company

NORTH

WEST

EAST

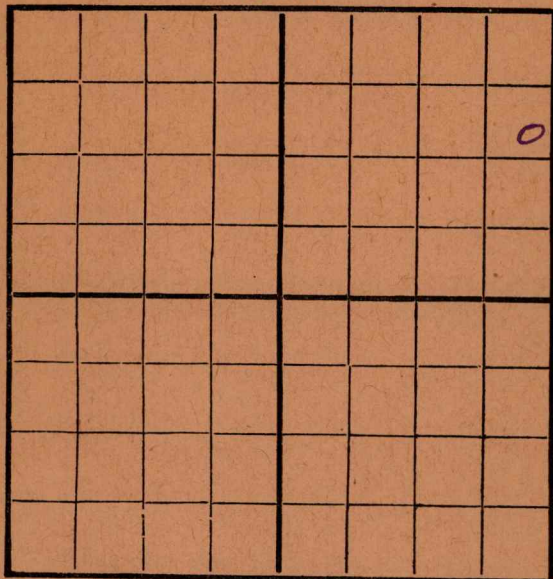

SOUTH

Location _____

Rig Up _____

Drilling and remarks

1050

RECORD

Cased _____ in. _____ Ft.

Sand _____

Gas _____

Oil _____

Total Depth _____

PRODUCTION

1st 24 hrs. Nat. _____

1st 24 hrs. after shot _____

Gas _____ Cu. Ft.

Dry Hole _____

Abandoned _____

Date

JAN 13 1917

191

E. H. WEST

Scout


COWLEY

Map No. _____ Sec. 15 Twp. 31 R. 5Well No. 1 Cochran Farm __________ BT 9 Company _____

NORTH

WEST

EAST

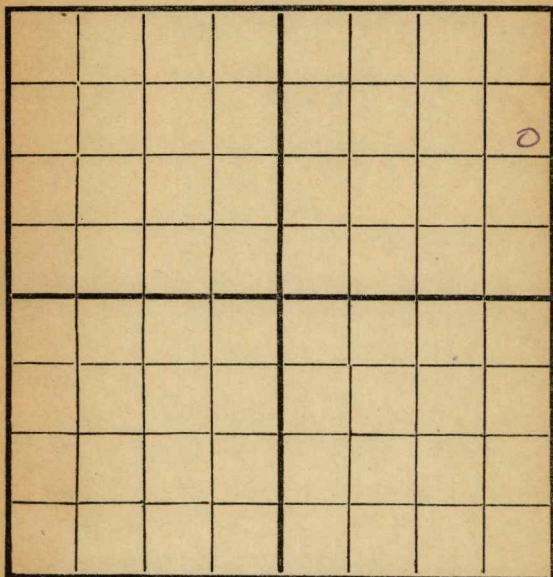

SOUTH

Location _____

Rig Up _____

Drilling and remarks

✓
1350

RECORD

Cased _____ in. _____ Ft.

Sand _____

Gas _____

Oil _____

Total Depth _____

PRODUCTION

1st 24 hrs. Nat. _____

1st 24 hrs. after shot _____

Gas _____ Cu. Ft.

Dry Hole _____

Abandoned _____

Date

JAN 20 1917

E. H. WEST

191

Scout


COWLEY

Map No. _____ Sec. 15 Twp. 31 R. 5Well No. 1 Cochran Farm
B+J Company

NORTH

WEST

EAST

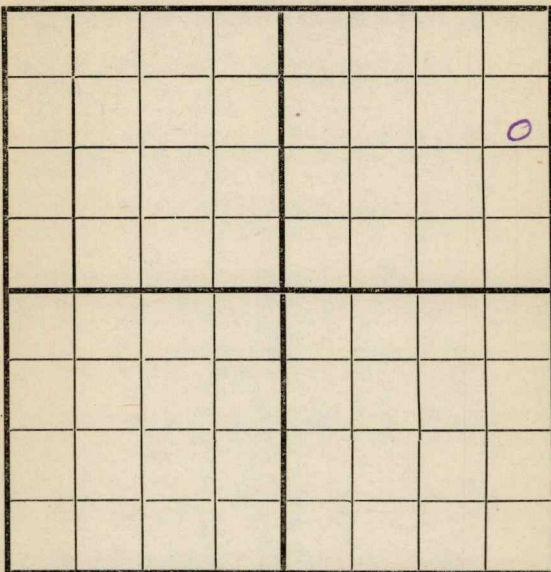

SOUTH

Location _____

Rig Up _____

Drilling and remarks
✓
1550

RECORD

Cased _____ in. _____ Ft.

Sand _____

Gas _____

Oil _____

Total Depth _____

PRODUCTION

1st 24 hrs. Nat. _____

1st 24 hrs. after shot _____

Gas _____ Cu. Ft.

Dry Hole _____

Abandoned _____

Date

JAN 27 1917


191

E. H. WEST

Scout

Map No. _____ Sec. 15 Twp. 31 R. 5
Well No. 1 Cochran Farm _____
B + J Company _____

NORTH

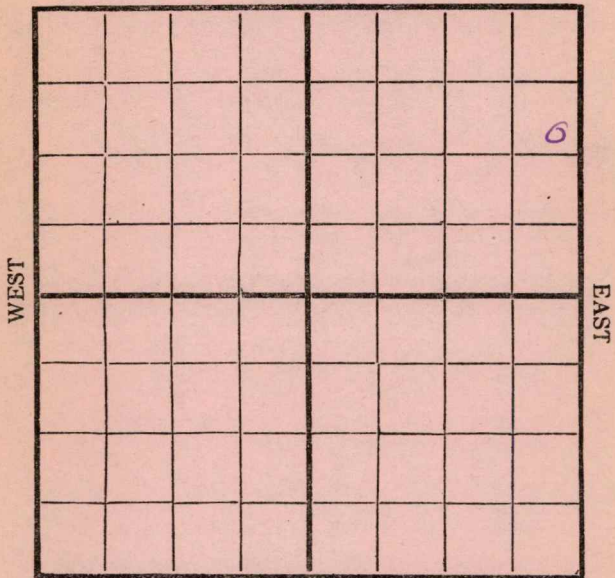

SOUTH

Location _____
Rig Up _____
Drilling and remarks
1800

RECORD

Cased _____ in. _____ Ft.
Sand _____
Gas _____
Oil _____
Total Depth _____

PRODUCTION

1st 24 hrs. Nat. _____
1st 24 hrs. after shot _____
Gas _____ Cu. Ft.
Dry Hole _____
Abandoned _____

Date _____

FEB - 3 1917


_____, 191 _____ E. H. WEST Scout

Cowley

Map No. _____ Sec. 15 Twp. 31 R. 5Well No. 1 Cochran Farm __________ B & T Company

NORTH

WEST

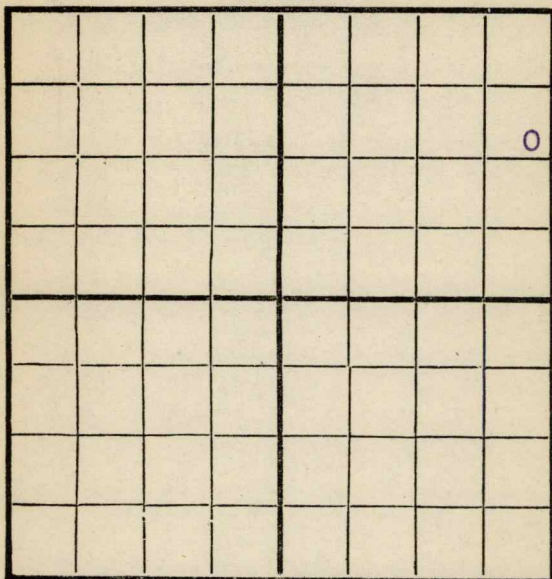

EAST

SOUTH

Location _____

Rig Up _____

Drilling and remarks

Fishing 1550

RECORD

Cased _____ in. _____ Ft.

Sand _____

Gas _____

Oil _____

Total Depth _____

PRODUCTION

1st 24 hrs. Nat. _____

First 24 hrs. after shot _____

Gas _____ Cu. Ft.

Dry Hole _____

Abandoned _____

Date

FEB 10 1917


191

E. H. WEST

Scout

Map No. _____ Sec. 15 Twp. 31 R. 5Well No. 1 Cochran Farm _____Don Edmund & Treese Company

NORTH

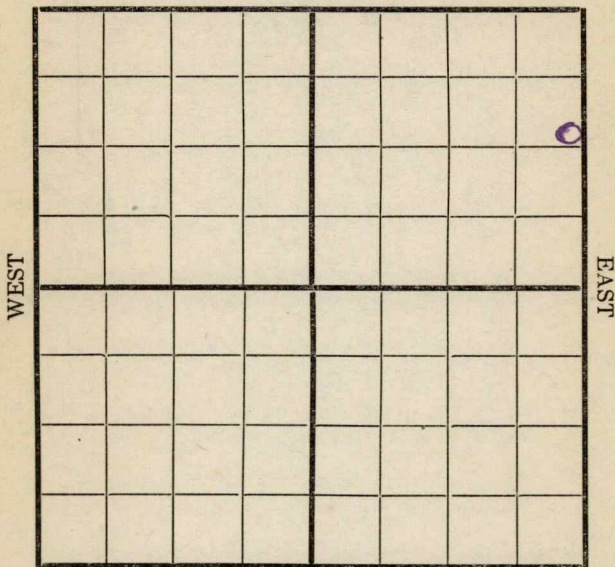

SOUTH

Location _____

Rig Up _____

Drilling and remarks

Fishing 1550

RECORD

Cased _____ in. _____ Ft.

Sand _____

Gas _____

Oil _____

Total Depth _____

PRODUCTION

1st 24 hrs. Nat. _____

1st 24 hrs. after shot _____

Gas _____ Cu. Ft.

Dry Hole _____


Abandoned _____

Date

FEB 17 1917

B. J. Crocker Scout

COWLEY

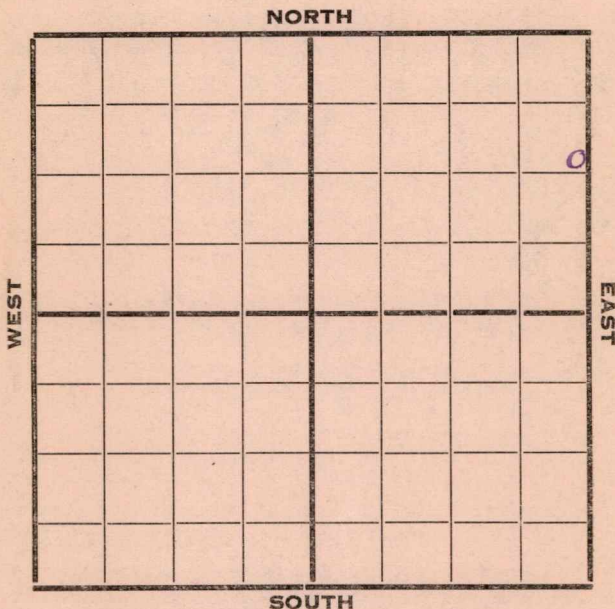Map No. _____ Sec. 15 Twp. 31 R. 5Well No. #1 Rockman FarmBenedum & Trust Company

Location _____

Rig up _____

Drilling and Remarks:

Fishing
1550

RECORD

Cased _____ in. _____ Ft.

Sand _____

Gas _____

Oil _____

Total Depth _____

PRODUCTION

1st 24 hrs. Nat. _____

1st 24 hrs. after shot _____

Gas _____ Cu. Ft.

Dry Hole _____

Abandoned _____

Date

FEB 24 1917


191

C. J. Crocker
Scout

COWLEY

Map No. _____ Sec. 15 Twp. 31 R. 5Well No. 1 Cochran FarmBenedum & Trees Company

NORTH

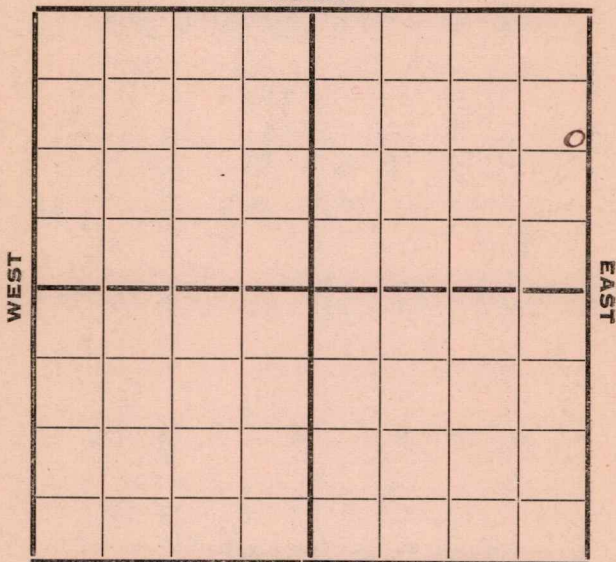

SOUTH

Location _____

Rig up _____

Drilling and Remarks:

Fishing
1536

RECORD

Cased _____ in. _____ Ft.

Sand _____

Gas _____

Oil _____

Total Depth _____

PRODUCTION

1st 24 hrs. Nat. _____

1st 24 hrs. after shot _____

Gas _____ Cu. Ft.

Dry Hole _____

Abandoned _____


Date

MAR 3 1917

191

B. T. Crocker
 Scout

Cowley

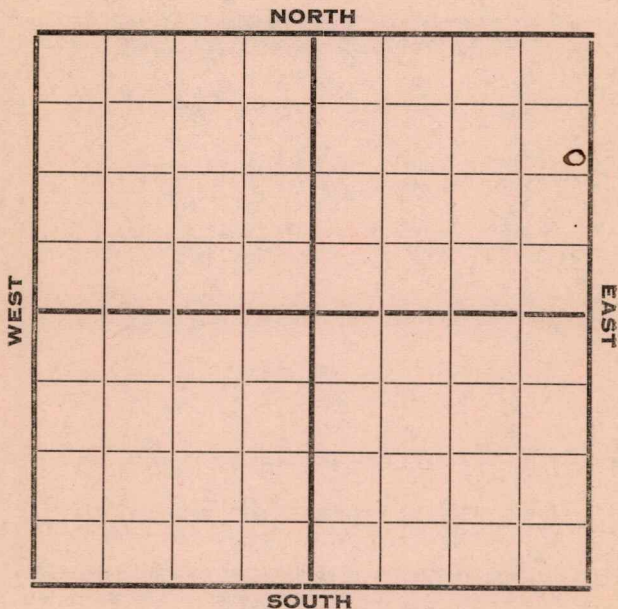Map No. Sec. 15 Twp. 31 R. 5Well No. #1 Cochran FarmBenedum & Freed Company

Location

Rig up

Drilling and Remarks:

Fishing 1550

RECORD

Cased in. Ft.

Sand

Gas

Oil

Total Depth

PRODUCTION

1st 24 hrs. Nat.

1st 24 hrs. after shot

Gas..... Cu. Ft.

Dry Hole

Abandoned

Date

3/10

191

7E. J. Crocker

Scout

COWLEY

Map No. _____ Sec. 15 Twp. 31 R. 5Well No. 1 Cochran FarmBenedum & Treas Company

NORTH

WEST

EAST

SOUTH

Location _____

Rig Up _____

Drilling and remarks

*Going to
skid Rig.*

RECORD

Cased _____ in. _____ Ft.

Sand _____

Gas _____

Oil _____

Total Depth _____

PRODUCTION

1st 24 hrs. Nat. _____

1st 24 hrs. after shot _____

Gas _____ Cu. Ft.

Dry Hole _____

Abandoned _____

Date

MAR 17 1917

G. J. Crocker Scout

Map No. *K2* Sec. *15* Twp. *31* R. *5*
 Well No. *1 Cochran* Farm
Benedum & Trees Company

NORTH

WEST

EAST

SOUTH

Location

Rig Up

Drilling and remarks

*Have moved
 Location to N.W.
 cor. of N.E $\frac{1}{4}$ now
 building rig*

RECORD

Cased in. Ft.

Sand

Gas

Oil

Total Depth

PRODUCTION

1st 24 hrs. Nat.

1st 24 hrs. after shot

Gas Cu. Ft.

Dry Hole

Abandoned

Date

MAR 24 1911


C. T. Crocker
 Scout

Map No. _____ Sec. 15 Twp. 31 R. 5
 Well No. 1 Cochran Farm
Benedum & Trust Company

NORTH

WEST

EAST

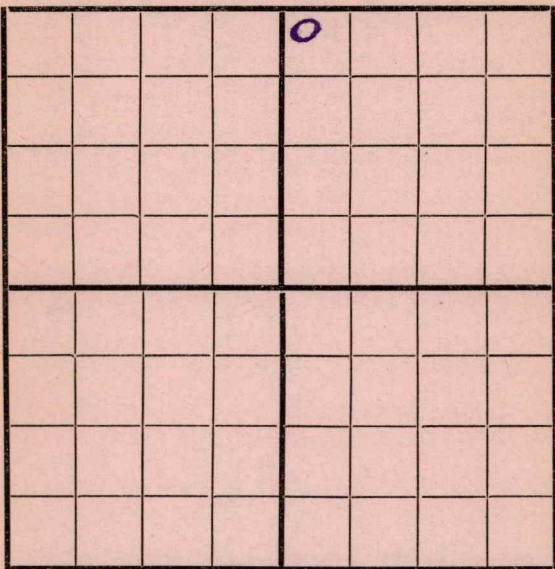

SOUTH

Location _____

Rig Up _____

Drilling and remarks

Rig up

RECORD

Cased _____ in. _____ Ft.

Sand _____

Gas _____

Oil _____

Total Depth _____

PRODUCTION

1st 24 hrs. Nat. _____

1st 24 hrs. after shot _____

Gas _____ Cu. Ft.

Dry Hole _____

Abandoned _____

Date

MAR 31 1917

C. T. Crocker Scout


Cowley

Map No. _____ Sec. *15* Twp. *31* R. *5*

Well No. *1 Cochran* Farm

Benedum & Trees Company

NORTH

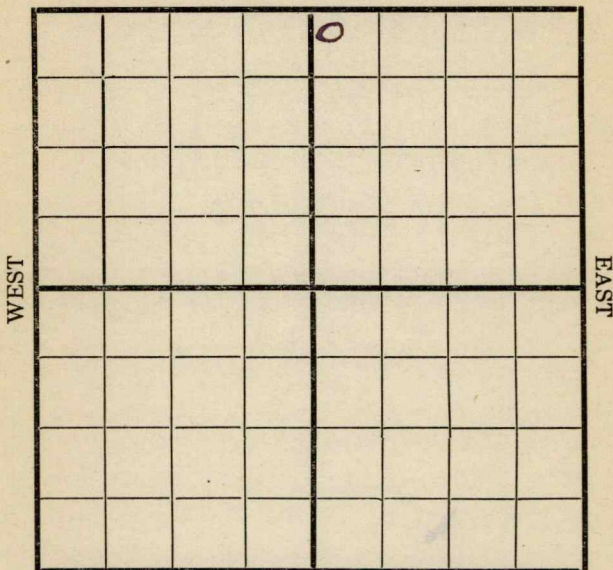

SOUTH

Location _____

Rig Up _____

Drilling and remarks _____

RECORD

Cased _____ in. _____ Ft.

Sand _____

Gas _____

Oil _____

Total Depth _____

PRODUCTION

1st 24 hrs. Nat. _____

1st 24 hrs. after shot _____

Gas _____ Cu. Ft.

Dry Hole _____

Abandoned _____

Date *APR 7* *1917*

_____, 191 _____

E. J. Crocker Scout

Map No. _____ Sec. 15 Twp. 31 R. 5
 Well No. 1 Cochran Farm
Benedum & Trees Company

NORTH

				O			

SOUTH

WEST

EAST

Location _____

Rig up _____

Drilling and remarks:

D-425'

RECORD

Cased _____ in. _____ Ft.

Sand _____

Gas _____

Oil _____

Total Depth _____

PRODUCTION

1st 24 hrs. Nat. _____

1st 24 hrs. after shot _____

Gas _____ Cu. Ft.

Dry Hole _____

Abandoned _____

Date

APR 14 1917

C. J. Crocker Scout

Map No. _____ Sec. 15 Twp. 31 R. 5Well No. 1 Cochran Farm _____Benedict & Trees Company

NORTH

WEST

EAST

SOUTH

Location _____

Rig Up _____

Drilling and remarks

D.-765Set 12 1/2" casing@ 765'

RECORD

Cased _____ in. _____ Ft.

Sand _____

Gas _____

Oil _____

Total Depth _____

PRODUCTION

1st 24 hrs. Nat. _____

First 24 hrs. after shot _____

Gas _____ Cu. Ft.

Dry Hole _____

Abandoned _____

Date

APR 21 1917

191

G. T. Crocker


Scout

Map No. _____ Sec. 15 Twp. 31 R. 5
 Well No. 1 Cochran Farm
Benedum & Trust Company

NORTH

WEST

EAST

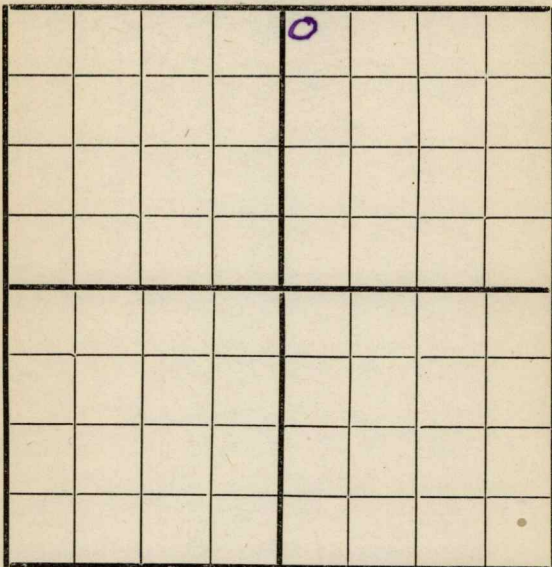

SOUTH

Location _____
 Rig Up _____
 Drilling and remarks

D-1210'

RECORD

Cased _____ in. _____ Ft.
 Sand _____
 Gas _____
 Oil _____
 Total Depth _____

PRODUCTION

1st 24 hrs. Nat. _____
 1st 24 hrs. after shot _____
 Gas _____ Cu. Ft.
 Dry Hole _____
 Abandoned _____


Date

4/28, 1917 Brooker Scout

COWLEY

Map No. _____ Sec. 15 Twp. 31 R. 5Well No. 1 Cochran Farm
Benedict & Sons Company

NORTH

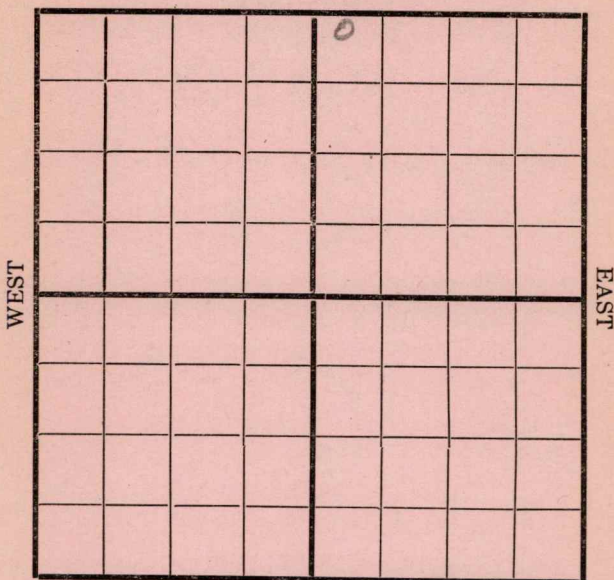

SOUTH

Location _____

Rig Up _____

Drilling and remarks

1500'

RECORD

Cased _____ in. _____ Ft.

Sand _____

Gas _____

Oil _____

Total Depth _____

PRODUCTION

1st 24 hrs. Nat. _____

1st 24 hrs. after shot _____

Gas _____ Cu. Ft.

Dry Hole _____

Abandoned _____

Date

5/9, 191 7 Cowley Scout

Map No. _____ Sec. 15 Twp. 31 R. 5
 Well No. 1 Cochran Farm
Benedict & Tree Company

NORTH

				0			

SOUTH

Location _____
 Rig Up _____
 Drilling and remarks _____

1680

RECORD

Cased _____ in. _____ Ft.
 Sand _____
 Gas _____
 Oil _____
 Total Depth _____

PRODUCTION


1st 24 hrs. Nat. _____
 1st 24 hrs. after shot _____
 Gas _____ Cu. Ft.
 Dry Hole _____
 Abandoned _____

Date

5/24 191 2 Cordiff Scout

Map No. _____ Sec. 15 Twp. 31 R. 5
Well No. 1 Cochran Farm _____
Cochran & Green Company _____

NORTH

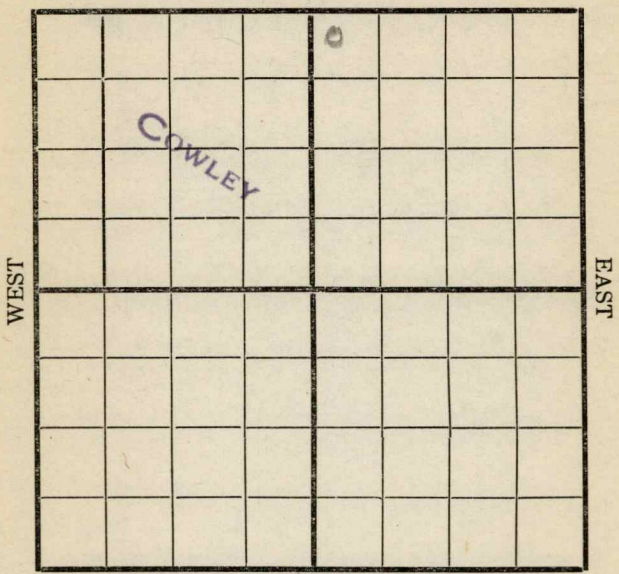

SOUTH

Location _____
Rig Up _____
Drilling and remarks _____

1745

RECORD

Cased _____ in. _____ Ft.
Sand _____
Gas _____
Oil _____
Total Depth _____

PRODUCTION

1st 24 hrs. Nat. _____
1st 24 hrs. after shot _____
Gas _____ Cu. Ft.
Dry Hole _____
Abandoned _____

Date 5/31, 1917 Cordell Scout


COWLEY

Map No. _____ Sec. 15 Twp. 31 R. 5
 Well No. 1 Cochran Farm _____
Benedict & Sons Company _____

NORTH

WEST

EAST

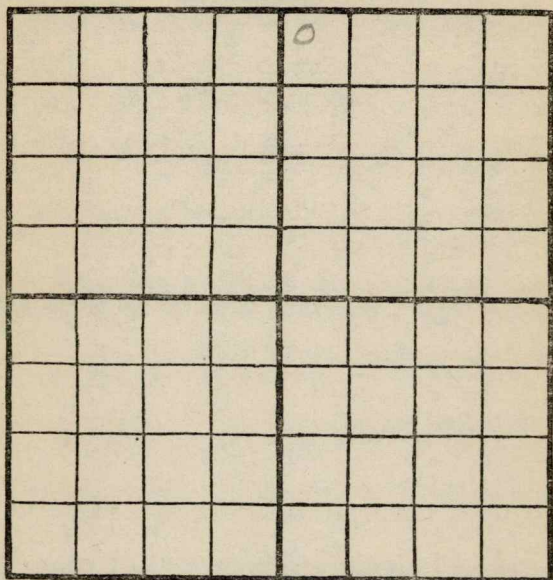

SOUTH

Location _____

Rig Up _____

Drilling and remarks

1910

RECORD

Cased _____ in. _____ Ft.

Sand _____

Gas _____

Oil _____

Total Depth _____

PRODUCTION

1st 24 hrs. Nat. _____

1st 24 hrs. after shot _____

Gas _____ Cu. Ft.

Dry Hole _____

Abandoned _____


Date

6/6, 1917, Candiff Scout

Map No. _____ Sec. 15 Twp. 31 R. 5
 Well No. 1 Cockran Farm _____
Benedict & Sons Company _____

NORTH

WEST

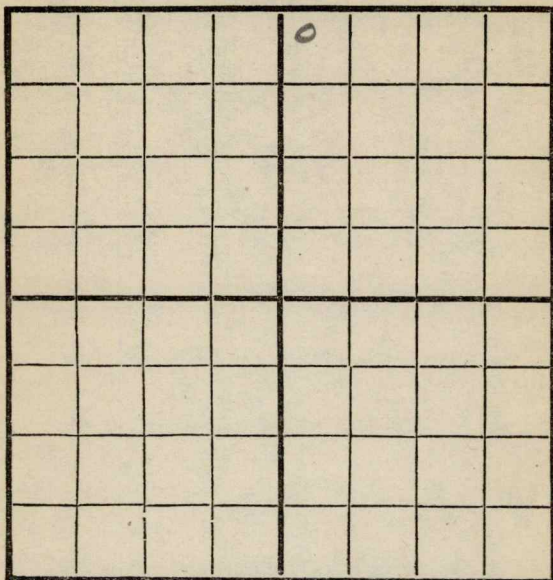

EAST

SOUTH

Location _____

Rig Up _____

Drilling and remarks

2370

COWLEY

RECORD

Cased _____ in. _____ Ft.

Sand _____

Gas _____

Oil _____

Total Depth _____

PRODUCTION

1st 24 hrs. Nat. _____

1st 24 hrs. after shot _____

Gas _____ Cu. Ft.

Dry Hole _____

Abandoned _____

Date


6/14, 1917, Cowley Scout

Map No. _____ Sec. 15 Twp. 31 R. 5Well No. 1 Coghlan FarmBenedict & Sons Company

NORTH

WEST

EAST

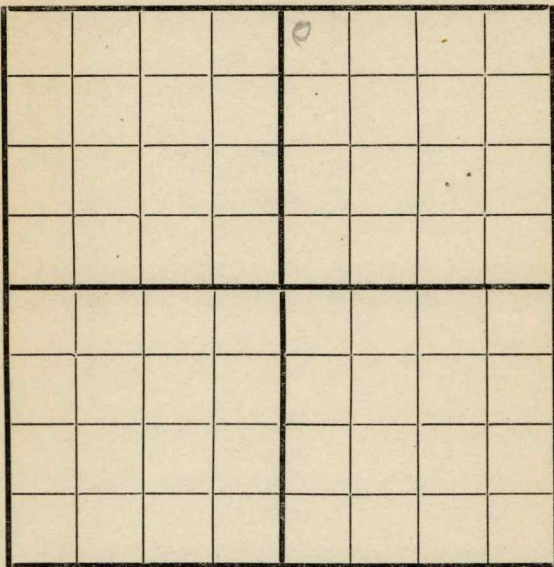

SOUTH

Location _____

Rig Up _____

Drilling and remarks

2512**COWLEY****RECORD**

Cased _____ in. _____ Ft.

Sand _____

Gas _____

Oil _____

Total Depth _____

PRODUCTION

1st 24 hrs. Nat. _____

1st 24 hrs. after shot _____

Gas _____ Cu. Ft.

Dry Hole _____


Abandoned _____

Date

6/24, 1917 Cowley Scout

Map No. _____ Sec. 15 Twp. 31 R. 5
 Well No. 1 Cochran Farm _____
Benedict & Sons Company _____

NORTH

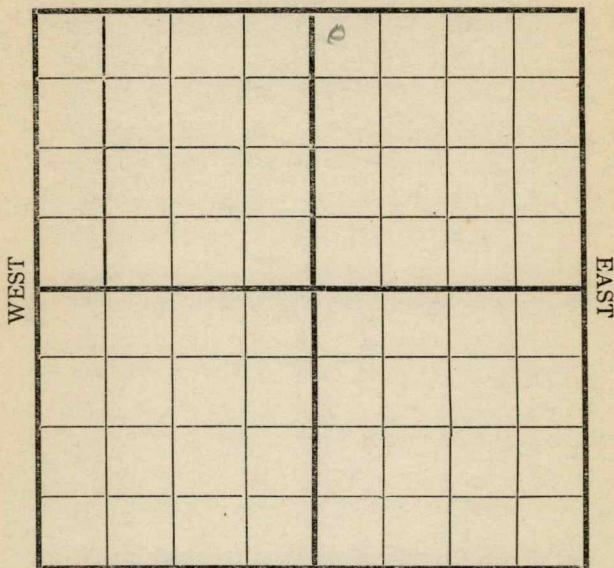

SOUTH

Location _____
 Rig Up _____
 Drilling and remarks _____

2700'

COWLEY

RECORD

Cased _____ in. _____ Ft.
 Sand _____
 Gas _____
 Oil _____
 Total Depth _____

PRODUCTION

1st 24 hrs. Nat. _____
 1st 24 hrs. after shot _____
 Gas _____ Cu. Ft.
 Dry Hole _____
 Abandoned _____

Date


6/28, 1917 Cowley Scout _____

Map No. _____ Sec. 15 Twp. 31 R. 5
 Well No. 1 Cochran Farm
Benjamin & Trees Company

NORTH

WEST

EAST

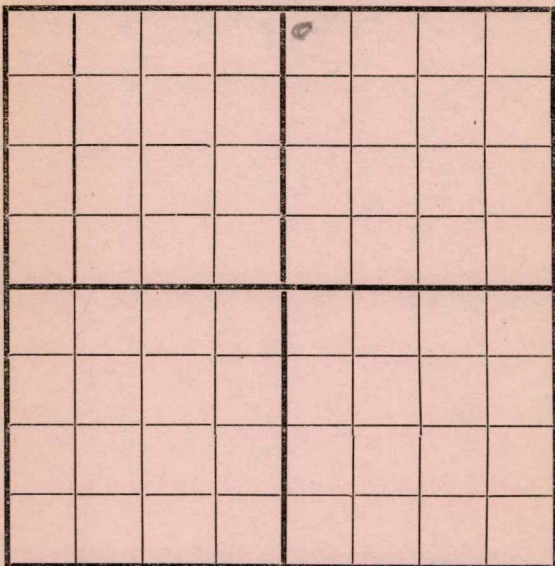

SOUTH

Location _____
 Rig Up _____
 Drilling and remarks _____

2970'

COWLEY

RECORD

Cased _____ in. _____ Ft.
 Sand _____
 Gas _____
 Oil _____
 Total Depth _____

PRODUCTION

1st 24 hrs. Nat. _____
 1st 24 hrs. after shot _____
 Gas _____ Cu. Ft.
 Dry Hole _____
 Abandoned _____

Date 7/6, 1917 Scout


Map No. _____ Sec. 15 Twp. 31 R. 5

Well No. 1 Cochran Farm _____

Benedict & Sons Company _____

NORTH

WEST

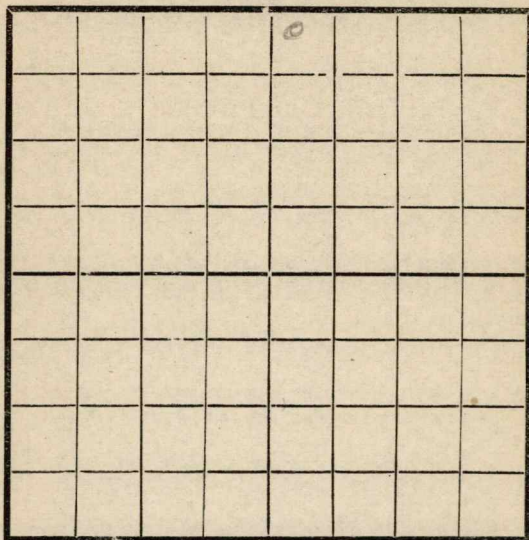

EAST

SOUTH

Location _____

Rig Up _____

Drilling and remarks

3200'

(Cowley Co.)

RECORD

Cased _____ in. _____ Ft.

Sand _____

Gas _____

Oil _____

Total Depth _____

PRODUCTION

1st 24 hrs. Nat. _____

1st 24 hrs. after shot _____

Gas _____ Cu. Ft.

Dry Hole _____

Abandoned _____

Date


7/12, 1917

G. Cowley

Scout

Map No. K-2 Sec. 15 Twp. 31 R. 5Well No. 1 Cochran FarmBenedum & Trees CompanyCowley NORTH Cowley

WEST

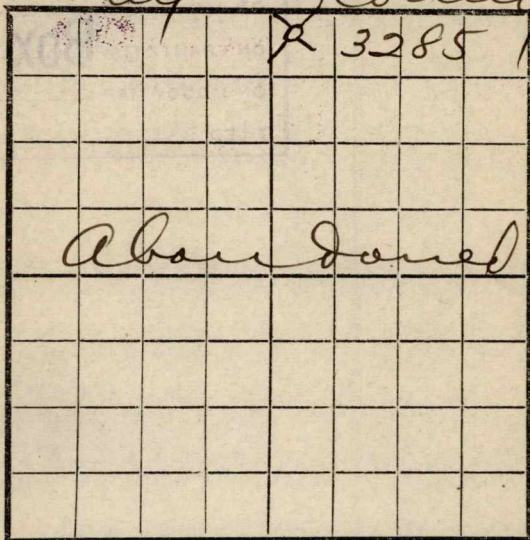

EAST

SOUTH

Location -----

Rig Up -----

Drilling and remarks

*Dry and
abandoned
3285*

RECORD

Cased ----- in ----- Ft.

Sand -----

Gas -----

Oil -----

Total Depth -----

PRODUCTION

1st 24 hrs. Nat. -----

1st 24 hrs. after shot -----

Gas ----- Cu. Ft.

Dry Hole -----

Abandoned -----

Date

8/18 7 Landiff Scout