


Rice

KANSAS

Section 7 Township 20 Range 10-W

Well Number 3 Bayer

Company Tatlock

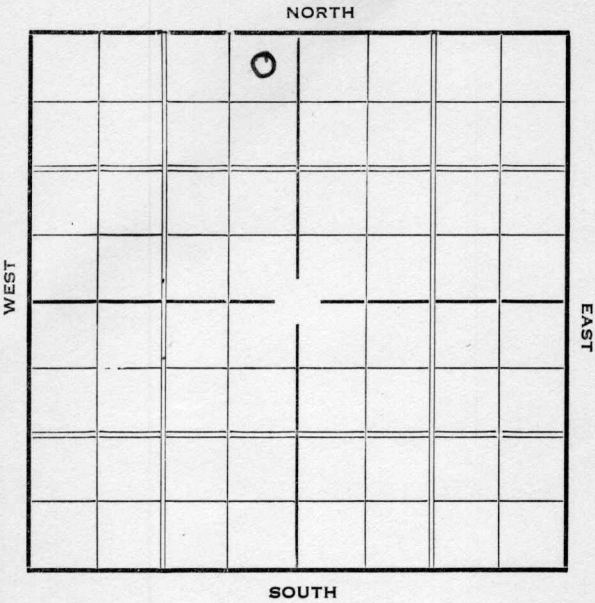

1937

7/28 7" @ 3308'.

Sil. 3307'.

T.D. 3312'.

1000 acid.

Pumped 34 1/6 hrs.

Pot. 1229 bbls.

COMPLETED

Rice KANSAS

Map No. 46 Sec. 7 Twp. 20 R. 10^WWell No. 3 - BayerTatlock Company

Contractor

FIRST REPORT

SECTION PLAT

	0		

330 Ft. from N. Line145 Ft. from S. Line330 Ft. from E. Line Ft. from W. LineLocation Rig up

Drilling and Remarks:

Rig

RECORD

Cased in., ft.Sand Gas Oil Total Depth

PRODUCTION

1st 24 hrs. Nat. 1st 24 hrs. after shot Gas Cu. Ft.Dry Hole Abandoned

Date

MAY 5 - 1937 19H. D. Hatfield Scout

Rice KANSAS

Map No. _____ Sec. 7 Twp. 20 R. 10^WWell No. 3-Bayer "B"Tatlock Company

Contractor _____

COMPLETED

SECTION PLAT

		0		

330 Ft. from N. Line

_____ Ft. from S. Line

330 Ft. from E. Line

_____ Ft. from W. Line

Location _____

Rig up _____

Drilling and Remarks:

1000 AcidPumped 34 1/6 hrsPot - 1229

RECORD

Cased 7 in., 3308 ft.Sand 511 3307

Gas _____

Oil _____

Total Depth 3312

PRODUCTION

1st 24 hrs. Nat. _____

1st 24 hrs. after shot _____

Gas _____ Cu. Ft.

Dry Hole _____

Abandoned _____

Date

JUL 28 1937H. D. Hatfield Scout