


Section 18 Township 18 Range 11 W

Well No. # 1 Hickel

Company Mid-Western Drlg.

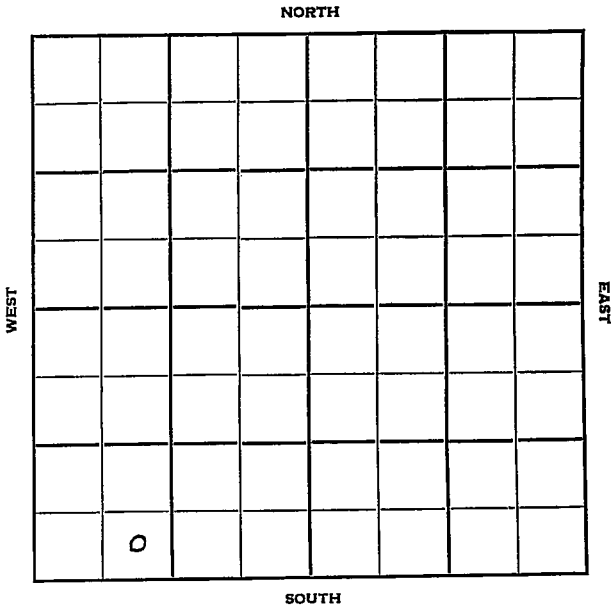

Sec. 18 Twp. 18 R. 11W ✓

Well No. #1 Hickel Farm

Mid-Western Drlg. Company

Contractor


Ft. from N. Line

330' Ft. from S. Line

Ft. from E. Line

990' Ft. from W. Line

SE SW SW

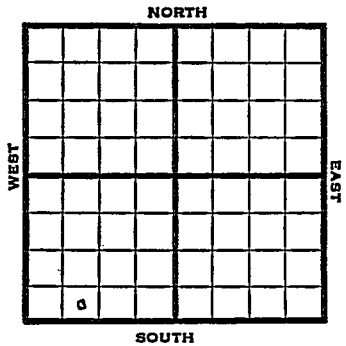

1951

Elev. 1812' REPORT

5/29 RUR

6/13

Spud 5-28-51

D & A TD 3457' 8" @ 235

Heeb 2987' Tor. 3006' Br. line

3101' Lans 3118'

DST 3107-83 open 1 hr. rec 60' mud

B KG 3370' Cong. 3389' Arb. 3425'

TD 3457' D & A

ABANDONED

