


Map No. KANSAS Sec. 17 Twp. 31 R. 5E
Well No. 2-Elliott Farm _____
Ham Elliott Company

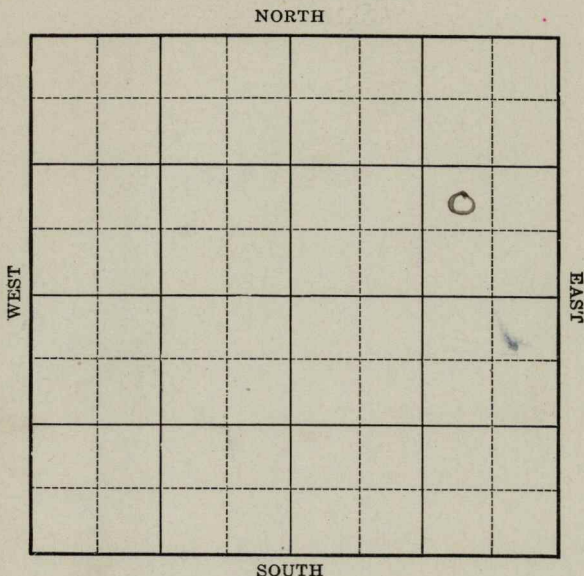

Location _____
Drilling Remarks _____

RECORD

Cased _____ in. _____ ft.
Sand _____
Gas _____
Oil _____
Total Depth _____

Rig Up _____
Drilling Remarks _____

PRODUCTION

1st 24 hrs. Nat. _____
1st 24 hrs. after shot _____
Gas _____ cu. ft.
Dry Hole _____
Abandoned _____


Map No. **KANSAS** Sec. 17 Twp. 31 R. 5E
 Well No. 2 - Elliott Farm
Sam Elliott Company

_____ Ft. from N. Line

990 Ft. from S. Line

990 Ft. from E. Line

_____ Ft. from W. Line

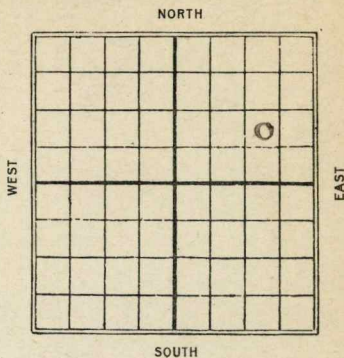

1928

Date

REPORT

4/26 Hrlg 410'

5/3 L

5/10 H. + a. 610'

Cowley

Map No. 2 **KANSAS** Sec. 17 Twp. 31 R. 5 ^E

Well No. 2 *Elliott*

Sam Elliott Company

Contractor

FIRST REPORTS

_____ Ft. from N. Line

990 Ft. from S. Line

990 Ft. from E. Line

_____ Ft. from W. Line

SECTION PLAT

			0

for gas

Location _____

Rig up _____

Drilling and Remarks:

Log 410'

RECORD

Cased _____ in., _____ ft.

Sand _____

Gas _____

Oil _____

Total Depth _____

PRODUCTION

1st 24 hrs. Nat. _____

1st 24 hrs. after shot _____

Gas _____ Cu. Ft.

Dry Hole _____

Abandoned _____

Date

APR 26 1928

CHAS. L. SHERWOOD

192

Scout

2 **KANSAS** 17 31 5
 MAP No. SEC. TWP. R.
 2 Elliott
 WELL No. Sam Elliott
 COMPANY

CONTRACTOR

COMPLETED**SECTION PLAT**

			0

FT. FROM N. LINE

990 FT. FROM S. LINE

990 FT. FROM E. LINE

FT. FROM W. LINE

ABANDONED

LOCATION

RIG UP

DRILLING AND REMARKS:

DQW 610'

RECORD

CASED IN. FT.

SAND

GAS

OIL

TOTAL DEPTH 610

PRODUCTION

1ST 24 HRS. NAT.

1ST 24 HRS. AFTER SHOT

GAS Cu. Ft.

DRY HOLE ✓

ABANDONED ✓

DATE

MAY 10 1928

CHAS. L. SHERWOOD

192

SCOUT