


Section 7 Township 20 Range 10-W

Well No. #3 Boyer "B"

Company Veeder Supply

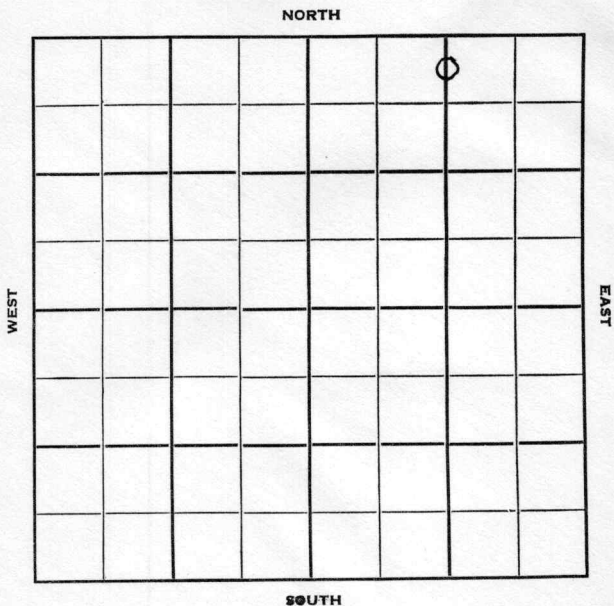

KANSAS

Rice

Sec. 7 Twp. 20 R. 10-W

Well No. #3 Boyer "B" Farm

Veeder Supply Company

Veeder Contr Contractor


Chase
330 Ft. from N. Line

 Ft. from S. Line

1320 Ft. from E. Line

 Ft. from W. Line

C N L NE

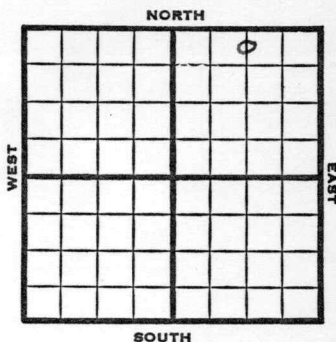

1951 Elev. 1812 REPORT

1/10
2/28

RUR

Spud 1-10-51

Oil Well TD 3165

8" @ 170 Br Lime 3052

Lans. 3070

DST 3146-65 opn 45 min

Rec. 900' muddy oil


5" @ 3146 TD 3165

S/8 boph 500 A

Comp. 100 bopd

COMPLETED

County Rice State Kansas
Sec. 7 (Blk.) 20 (Sur.) 10W Map No.
Operator Veeder Supply
Well No. 3 Farm Boyer "B"
Elev. Location C N L NE

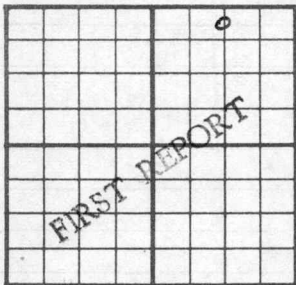

330 Ft. From N Line NE
1320 Ft. From E Line Quarter
1st. Report JAN 10 1950

Completion

Remarks

Veeder - Contr.

Spudding Date

Drlg. Data

Chase Pool

R U R

J. E. TYRA

County Rice State KansasSec. 7 (Blk.
Twp.) 20 (Sur.
Rge.) 10W Map No.Operator Veeder SupplyWell No. 3 Farm Boyer "B"Elev. 1812 Location C N L NE

330 Ft. From N Line NE1320 Ft. From E Line Quarter

1st. Report

Completion FEB 28 1951Remarks Chase PoolVeeder - Contr.Spudding Date 1-10-51Drlg. Data Oil well TD 31658" @ 170 Br. lime 3052 Lans. 3070DST 3146-65 open 45 min. Rec. 900'muddy oil 5" @ 3146 TD 3165 S/ 8 boph500 A Comp. 100 bopd

J. E. TYRA