

KANSAS


Rice

FORM 51 5M 10-41 PETROL

Section 9 Township 20 Range 10-W

Well No. 1 Schubert

Company Sharon Drilling et al

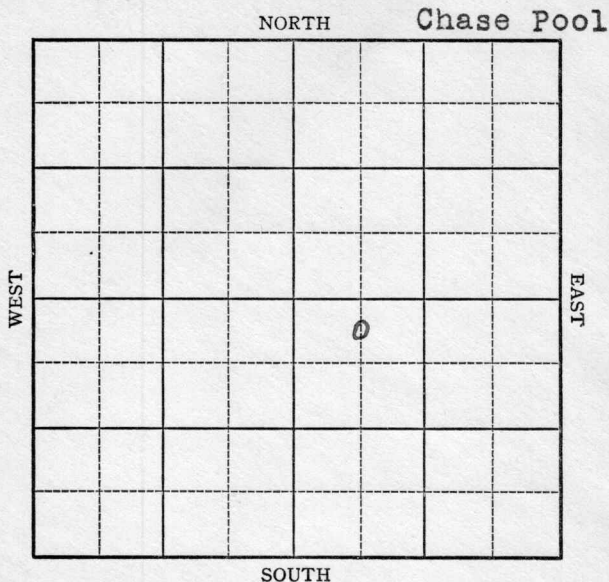

KANSAS

Rice

Map No. 46 Sec. 9 Twp. 20 R. 10WWell No. 1 SchubertSharon Drilling et al. Company

FIRST REPORT

Contractor

C NL NW SE

SECTION PLAT

		o	

330 Ft. from N. Line Ft. from S. Line Ft. from E. Line660 Ft. from W. Line

CHASE POOL

Location Rig up

Drilling and Remarks:

Rotary

RECORD

Cased in., ft.Sand Gas Oil Total Depth

PRODUCTION

1st 24 hrs. Nat. 1st 24 hrs. after shot Gas Cu. Ft.Dry Hole Abandoned

Date

JAN 14 1942 19

S. J. LEWIS Scout

Rice

KANSAS

Map No. 46 Sec. 9 Twp. 20 R. 10WWell No. 1 SchubertSharon Drilling et al. CompanyABANDONED

Contractor

C NL NW SE

330 Ft. from N. Line Ft. from S. Line Ft. from E. Line660 Ft. from W. Line

SECTION PLAT

		0	

CHASE POOL

Location Rig up

Drilling and Remarks:

Cr 3421.5" C 3391Water

RECORD

Cased in., ft.Sand Gas Oil Total Depth 3424

PRODUCTION

1st 24 hrs. Nat. 1st 24 hrs. after shot Gas Cu. Ft.Dry Hole Abandoned

Date

FEB 11 1942

19

S. J. LEWIS Scout