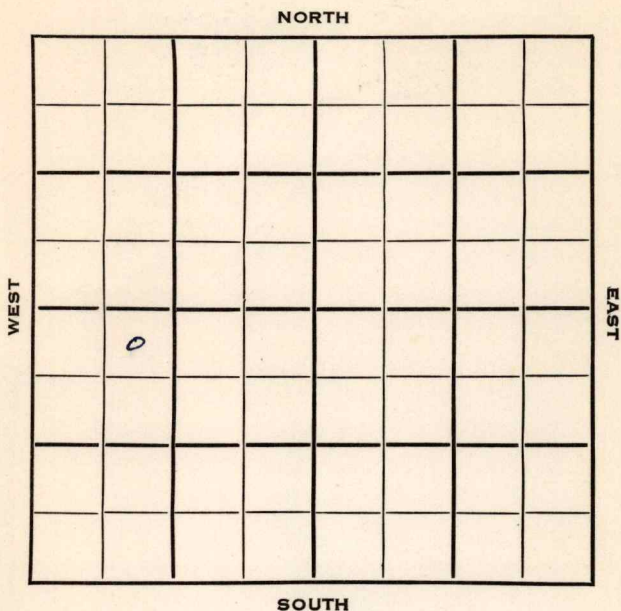


Section 17 Township 31 Range 5EWell No. 1 JohnsonCompany Arrow Petroleum

Cowley

KANSAS ✓

Sec. 17 Twp. 31 R. 5EWell No. #1 Johnson FarmArrow Petr.


Company

Cappit Drlg.

Contractor

330 Ft. from N. Line         Ft. from S. Line         Ft. from E. Line990 Ft. from W. Line

NE NW SW

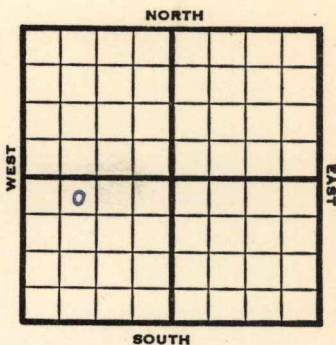1953 **Elev. 1209'** REPORT1/28 Spud 1-26-53  
8" @ 91

Drlg. 346

4/15 Spud 1-26-53

D &amp; A

TD 2910'

8" @ 91'

**Stal. 1805, Layton 2207, KC 2228,  
Oswego 2586, Bart 2837, Miss 2887,**

TD 2910

5" @ 2910'

24/ 2832-38 S/ 16 gwph Hydro.

S/ 16 bwph CO to 2864

**41/ 2838-44 oil-frac S/ 1 boph went  
to wtr.**

D&amp;A

**ABANDONED**



County Cowley State Kansas  
 Sec. 17 (Blk.) 31 (Sur.) 5E Map No.  
 Operator Arrow Pet.  
 Well No. 1 Farm Johnson  
 Elev. 1209 Location NE NW SW (twin well)



330 Ft. From N Line SW

990 Ft. From W Line Quarter

1st. Report

Completion APR 15 1953

Remarks

Cappit Drlg. - Contr.

Spudding Date 1-26-53

Drlg. Data D &amp; A TD 2910

8" @ 91 Stal. 1805 Layton 2207

KC 2228 Oswego 2586 Bart. 2837

Miss. 2887 TD 2910 5" @ 2910

24/ 2832-38 S/ 16 gwph Hydro.

S/ 16 bwph CO to 2864 41/ 2838-44

oil-frac S/ 1 boph went to wtr.

D &amp; A

J. G. McGEHEE