


SECTION 17 TOWNSHIP 31 RANGE 5 E

WELL NO. # 1 Lewis

COMPANY Bedell & Catt

NORTH

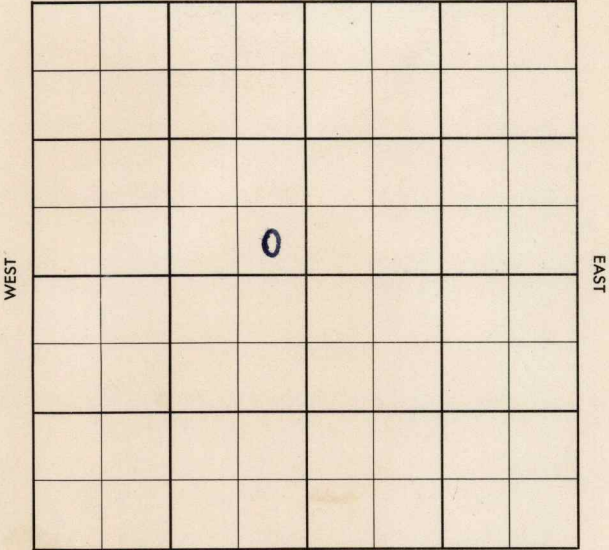

SOUTH

WEST

EAST

Cowley

**KANSAS**

SEC. 17	TWP. 31	R. 5E
------------	------------	----------

WELL NO. #1 Lewis FARM

COMPANY  
Bedell & Catt

CONTRACTOR  
Co. Tools

Wilmot-Floral


\_\_\_\_\_ Ft. from N. Line

\_\_\_\_\_ Ft. from S. Line

\_\_\_\_\_ Ft. from E. Line

\_\_\_\_\_ Ft. from W. Line

SE SE NW

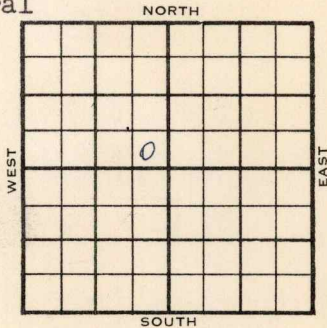

1956

ELEVATION

**1219'**

REPORT

4-25

Comm. 4-20-56  
8" @ 74  
Drlg. 1270

5-2

**D & A**  
**Lay 2196**  
**KC 2264**  
**Clev 2474**  
**Osw. 2516**  
**Barlt. Zn. 2805**  
**M. 2874**  
**TD 2895'**

**ABANDONED**

Co.

County Cowley Elev. 1219  
 Sec. 17 Twp. 31 Rge. 5E  
 Company Bedell & Catt  
 Farm Name Lewis No. 1

TOPS	DEPTH	LOG	DATUM
Anh.			
TP.			
H. <u>L24</u>	<u>2196</u>		<u>977</u>
Tr.			
Dg.			
Bl.			
L.			
K.C.	<u>2264</u>		<u>1095</u>
B.H. <u>clev</u>	<u>2474</u>		<u>1255</u>
Ge. <u>OSW</u>	<u>2516</u>		<u>1297</u>
C. <u>Bartl. 20</u>	<u>2805</u>		<u>1586</u>
M.	<u>2874</u>		<u>1655</u>
M.			
K.			
Mz.			
Me.			
V.			
S.			
S.			
A.			
R.			
PE.			
G.			
TD.	<u>2895</u>		

Loc. in Sec. SE SE NW

Geol. \_\_\_\_\_  
 Contr. \_\_\_\_\_  
 Co. tools \_\_\_\_\_

Pool \_\_\_\_\_  
 Wilmot-Floral \_\_\_\_\_



ABANDONED

Lse.

No.

Sec.

T.

R.

Date Comm. 4-20-56 MAY 2 1956

8" @ 74 drlg. 1270 MAY 2 1956

D&A

County Cowley Elev. \_\_\_\_\_  
 Sec. 17 Twp. 31 Rge. 5E  
 Company Bedell & Catt  
 Farm Name Lewis No. 1

TOPS	DEPTH	LOG	DATUM	Loc. in Sec.
Anh.				SE SE NW
Tr.				
Dg.				
Bl.				
L.				Geol. _____
K.C.				Contr. _____
B.K.C.				Co. tools _____
Ce.				
C.				
M.				Pool _____
M.				Wilmot-Floral
K.				
Mz.				
Me.				
V.				
S.				
S.				
A.				
R.				
PE.				
G.				
T.D.				

FIRST REPORT  
 APR 25 '66

Date Comm. 4-20-56  
8" @ 74 drlg. 1270

MAY 5 1956

R. G.

*219*