


Section 19 Township 18 Range 11 W

Well No. # 1 Schrepel "B"

Company Sohio Oil

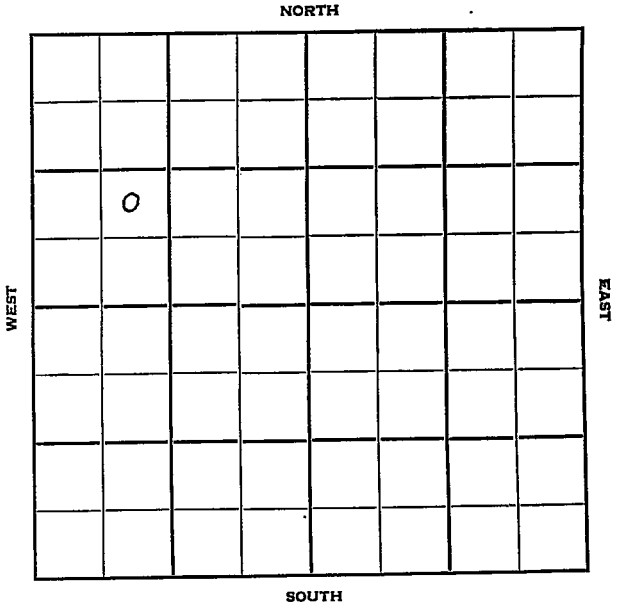

Sec. 19 Twp. 18 R. 11 W ✓

Well No. # 1 Schrepel "B" Farm

Sohio Oil Company


Strain Drlg. Contractor

_____ Ft. from N. Line

990 Ft. from S. Line

_____ Ft. from E. Line

990 Ft. from W. Line

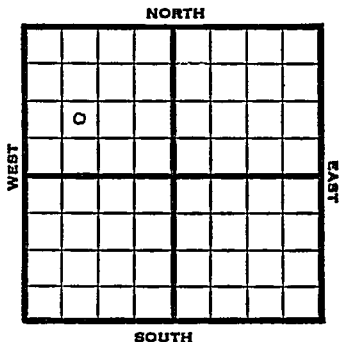

NE SW NW

1951 Elev. 1809' REPORT

5/2 Spud 4-25-51
 Anhy 654'
 8" @ 662'
 Drlg. 2300'

5/9 Spud 4-25-51
 D & A TD 3438'
 Anhy 654' 8" @ 662' Top. 2630'
 Heeb 2964' Br. lime 3069',
 Lans. 3085',
 DST 3102-17 open 1/2 hr. rec 250' gas,
 18' GCM

DST 3158-73 open 1 hr. rec 50' mud & SW
 DST 3231-46' open 1 hr. rec 15' mud &
 SW
 Arb. 3388' TD 3438'
 D & A

ABANDONED

5/16 O.W.W.O.

Reported D & A last week. Corrected tops
 Top 2620, Heeb 2961' Br lime 3070'
 Lans. 3084' Arb. 3386-3435' TD
 5" @ 3434

OVER

1951

5/29 Oil Well TD 3435
Top. 2620' Heeb. 2961
Br Lime 3070 Lans. 3084
Arb. 3386-3435
5" @ 3434 6/3388-90 500 A
2½ bwph SP 3283
16/3262-66 500 A 2½ bfph 70% oil
dec. to 1 go 28 gwph SP 3254
20/3229-34 500 A 1-3/4 bw 4 hr
SP 3172 16/3147-51 wtr 24/3109-15
500 A 3000 A S/28 bo 8 hr.
S/1 boph Comp. 30 bopd

COMPLETED

County **Barton** State **Kansas**

Sec. **19** (Blk. Twp.) **18** (Sur. Rge.) **11W** Map No.

Operator **Sohio Oil**

Well No. **1** Farm **Schrepel "B"**

Elev. Location **NE SW NW**

990 Ft. From **S** Line **NW**

990 Ft. From **W** Line **Quarter**

Ist. Report **MAY 2 1951**

Completion

Remarks

Strain Drlg. - Contr.

Spudding Date **4-25-51**

Drlg. Data

Anhy 654 8" @ 662 drlg. 2300

J. E. TYRA

