

Rice

KANSAS

SECTION 8 TOWNSHIP 20 RANGE 10W

WELL NO. #1 Boyer

COMPANY Thunderbird Drlg

NORTH

	0						

WEST

EAST

SOUTH

Rice

SEC. 8	TWP. 20	R. 10W
-----------	------------	-----------


WELL NO. #1 Boyer FARM

COMPANY Thunderbird Drlg.

CONTRACTOR

Raymond

_____ Ft. from N. Line
 _____ Ft. from S. Line
 _____ Ft. from E. Line
 _____ Ft. from W. Line

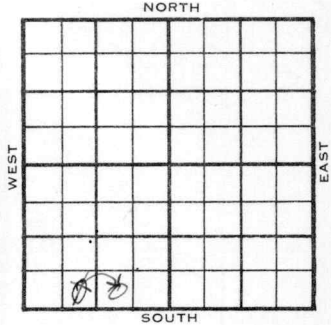

~~SE~~ SW SW
 SW SE

1956	ELEVATION 1809'	REPORT
------	--------------------	--------

4-25 Comm. 4-19-56
 8" @ 202 w/140
 Drlg. 2590

5-23 DST 3368-75 op 1 hr. rec. 300' oil,
 BHP 800/20".
 5 1/2" @ 3368 w/50
 CO 3375
 S/ 2 1/2 boph, no/wtr., 6 hrs.
 P/ 50 bopd, no/wtr.
 P/ 25 bopd, no/wtr.
 H. 2924', BL. 3047', L. 3064',
 A. 3366'.
 TD 3375'

COMPLETED

County Rice Elev. _____
 Sec. 8 Twp. 20 Rge. 10W
 Company Thunderbird Drlg.
 FarmName Boyer No. 1

TOPS	DEPTH	LOG	DATUM	Loc. in Sec.
Anh.				SE SW SW
TP.				
H.				
Tr.				
Dg.				
Bl.				
L.				Geol. _____
K.C.				Contr. _____
B.K.C.				
Ce.				
C.				
M.				
M.				Pool <u>Silica</u>
K.				<u>Raymond</u>
Mz.				
Me.				
V.				
S.				
S.				
A.				FIRST REPORT
R.				
PE.				APR 25 '56
G.				
T.P.				

Date Comm. 4-19-56
8" @ 202/140 drlg. 2590

MAY 3 1956
 R. G. R.

[Handwritten signature]

Co.
Lse.
No.
Sec.
T.
R.

CORRECTION

FORM 513 SUNRAY

County Rice Elev. 1809
 Sec. 8 Twp. 20 Rge. 10W
 Company Thunderbird Drlg.
 Farm Name Bayer No. 1

TOPS	DEPTH	LOG	DATUM	Loc. in Sec.
Anh.				<div style="border: 1px solid black; border-radius: 50%; padding: 5px; display: inline-block;"> SE SW SW SW SE </div>
Tr.	2924			
Dg.				<div style="border: 1px solid black; border-radius: 50%; padding: 5px; display: inline-block;"> SILICA </div>
Bl.	3047			
L.	3064			<div style="border: 1px solid black; border-radius: 50%; padding: 5px; display: inline-block;"> Raymond </div>
K.C.				
B.K.C.				<div style="border: 1px solid black; border-radius: 50%; padding: 5px; display: inline-block;"> COMPLETE </div>
Ce.				
C.				<div style="border: 1px solid black; border-radius: 50%; padding: 5px; display: inline-block;"> 80 </div>
M.				
K.				
Mz.				
Mo.				
V.				
S.				
S.				
A.	3366			
R.				
Pe.				
G.				
TD.	3375			

Date Comm. 4-19-56 MAY 23 1956
8" @ 202/140 drlg. 2590 MAY 2 '56 DST
3368-75 1hr no 300' oil
BHP 880/20 5 1/2 3368/50 MAY 9 '56
WOCT MAY 15 '56 co 3375 & 2 1/2 Bopd
now 6 hrs POP. MAY 23 '56 P. 50
Bopd now P. 25 Bopd
now wte.