


Well 1- Burschert Farm
Twin Drilling Co itab Company

NORTH

WEST

EAST

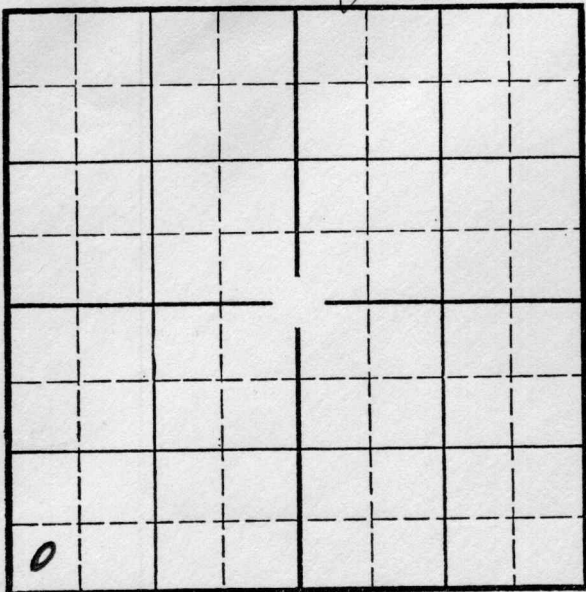

1793

SOUTH

O. W. D. D

Location _____
Drilling Remarks _____

Rig Up _____
Drilling Remarks _____

RECORD

Cased _____ in. _____ ft.
Sand _____
Gas _____
Oil _____
Total Depth _____

PRODUCTION


1st 24 hrs. Nat. _____
1st 24 hrs. after shot _____
Gas _____ cu. ft. _____
Dry Hole _____
Abandoned _____

16-175

Rice

Map No. KANSAS Sec. 8 Twp. 20 R. 10W
Well No. 1- Burchett Farm
Twin Oly sub Company

 Ft. from N. Line
330 Ft. from S. Line
 Ft. from E. Line
330 Ft. from W. Line

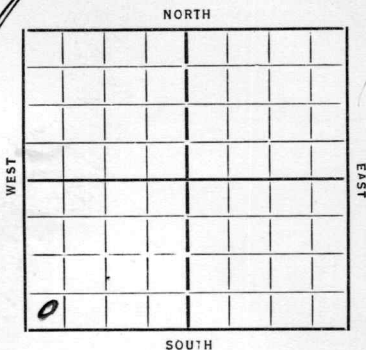

Date 1935 REPORT O.W.D.D

6/24 Cellar
7/3 7/11 - 7/18
8/8 Oly 345 15" 140
8/15 and 465 13" 462
8/22 Oly 1275
8/22 10" 1700 C.O.
8/29 Oly 1872 10" 1843
9/6 " 2005
10/3 " 2478 8" 2394
10/10 8" 2549
11/1 1000 Acid To re treat
11/7 5" 3335 TD 58
11/7 Oil 3335 TD 3340
11/14 Shot w/10 gts
11/14 TD 3358 SD.
11/21 pumped 38 bbls 24 hrs.
11/29 SD Will shoot & acidize
12/6 SD.
12/11 Top Oil 3335
12/11 TD 3358 1/2
12/11 Shot 10 gts
12/11 ot 38 Oil

OVER

COMPLETED

1936

O. W. D. D

2/12 O T D 3358 1/2

HFW 3392

T D 3399.

FIRST REPORTS

✓

ABANDONED

Map No. 46 Sec. 8 Twp. 20 R. 10N

Well No. 1 Buscher

Twin Drilling & Co. Company

Contractor

SECTION PLAT

.....Ft. from N. Line

330 Ft. from S. Line

.....Ft. from E. Line

330 Ft. from W. Line

FIRST REPORTS

Location.....

Rig up.....

Drilling and Remarks:

Cellar

RECORD

Cased.....in.,ft.

Sand.....

Gas.....

Oil.....

Total Depth.....

PRODUCTION

1st 24 hrs. Nat.....

1st 24 hrs. after shot.....

Gas.....Cu. Ft.

Dry Hole.....

Abandoned.....

Date

6/26/35 192.....

ORVAL MANNSCHRECK

Scout

Map No. 46 Sec. 8 Twp. 20 R. 10W

Well No. 1 - Burchett

Twin Drly etal Company

Contractor

SECTION PLAT

.....Ft. from N. Line

330 Ft. from S. Line

.....Ft. from E. Line

330 Ft. from W. Line

0			

COMPLETED

Location.....

Rig up.....

Drilling and Remarks:

shot w/10 gts

Got 38 oil

RECORD

Cased.....in.,ft.

Sand Til 3335

Gas.....

Oil.....

Total Depth 3358 1/2

PRODUCTION

1st 24 hrs. Nat.....

1st 24 hrs. after shot.....

Gas.....Cu. Ft.

Dry Hole.....

Abandoned.....

Date

12-11-35 192

ORVAL MANNSCHRECK

Scout

KANSAS

Map No. 46 Sec. 8 Twp. 20 R. 10WWell No. 1-1500000Twin Legs Co Company

Contractor

FIRST REPORTS
ABANDONED

SECTION PLAT

Ft. from N. Line

330 Ft. from S. Line

Ft. from E. Line

330 Ft. from W. Line

Location.....

Rig up.....

Drilling and Remarks:

OTN 3358 1/2HFW 339210 + 17

RECORD

Cased.....in.,ft.

Sand.....

Gas.....

Oil.....

Total Depth 3399

PRODUCTION

1st 24 hrs. Nat.....

1st 24 hrs. after shot.....

Gas.....Cu. Ft.

Dry Hole.....

Abandoned.....

Date

2-12-36 192.....Orval M. C.
J. P. B. Scout