


Section 20 Township 18 Range 11W

Well No. #1 Straub

Company Shelly-Miller Drlg.

NORTH

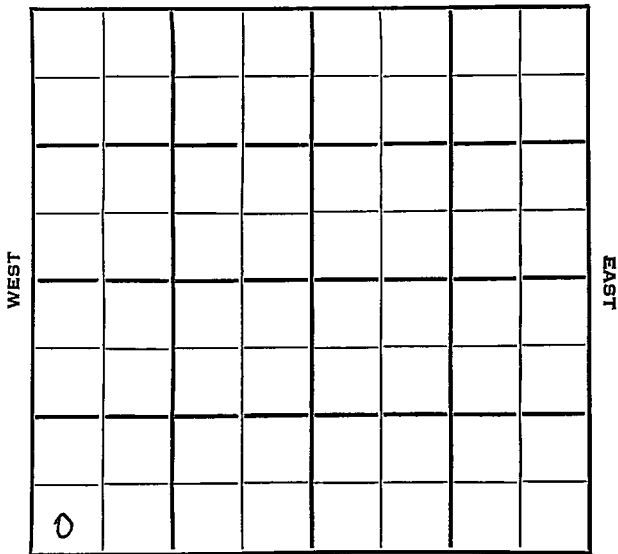

SOUTH

Barton KANSAS


SEC.	TWP.	R.
20	18	11W ✓

WELL NO. **1 Straub** FARM

COMPANY **Shelly-Miller Drlg.**

CONTRACTOR **Shelly-Miller Wildcat**

\_\_\_\_\_ Ft. from N. Line  
**330** \_\_\_\_\_ Ft. from S. Line  
 \_\_\_\_\_ Ft. from E. Line  
**330** \_\_\_\_\_ Ft. from W. Line

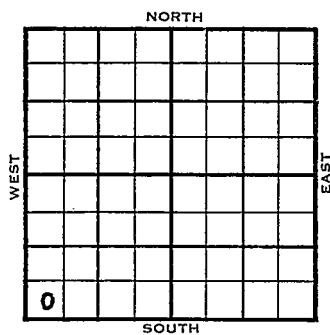

SW SW SW

1953	ELEVATION 1822'	REPORT
------	--------------------	--------

11/11 Spud 11-9-53  
 8" @ 158', WOC

11/18 Anhy 663', Heeb 2997', Br li 3107',  
 Lans 3124'  
 Drlg. 3140'

11/24 Spud 11-9-53  
 D & A  
 TD 3460'  
 8" @ 158'  
 Anhy 663, Heeb 2997, Br. Lime 3107  
 Lans 3124, Cong 3392, Ch Cong 3424,  
 Arb 3446'  
 TD 3460'  
 D & A

**ABANDONED**



