

Rice


FORM 51

KANSAS

Section 11 Township 20 Range 10W

Well No. #1 Scott

Company Rex & Morris

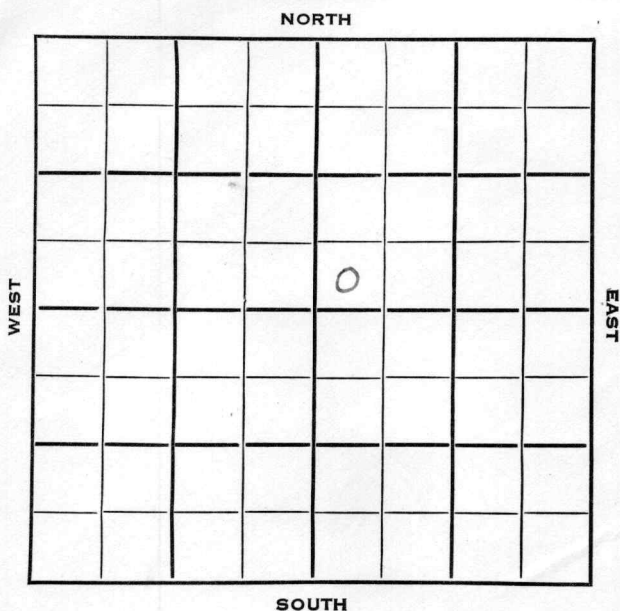

SEC.	TWP.	R.
11	20	10W ✓

WELL NO.

1 Scott

FARM

COMPANY

Rex & Morris

CONTRACTOR

Rex & Morris

Wildcat

Ft. from N. Line

330


Ft. from S. Line

Ft. from E. Line

330

Ft. from W. Line

SW SW NE

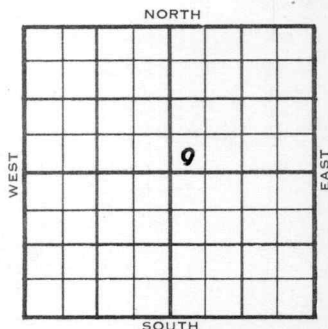

1954

ELEVATION

1775'

REPORT

1/20

MIR

1/27

8" @ 234'
D rlg. 3030'

2/3

Spud 1-22-54

D&A

TD 3378'

8" @ 234'

Top 2583', Heeb 2854', Dodge 2872',
Br lime 2984', L ans 3009'

DST 3176-93', opn 35 mins., rec.

25' mud,

B. Penn. Cong 3289', Simp. sh 3326',

Simp sd 3334'

DST 3334-40', opn 1 hr., rec. 20' mud

Arb. 3346'

DST 3339-48', opn 1 hr., rec. 355'

sul wtr., 1050#

TD 3378'

D&A

ABANDONED

County **Rice** State **Kansas**Sec. **11** (Blk.) **20** (Sur.) **10W** Map No.Operator **Rex & Morris**Well No. **1** Farm **Scott**Elev. Location **SW SW NE****330** Ft. From **S** Line **NE****330** Ft. From **W** Line Quarter**JAN 20 1954**

1st. Report

Completion

Remarks


Rex & Morris - Contr.

Spudding Date

Drlg. Data

Wildcat**M I R**

J. G. McGEHEE

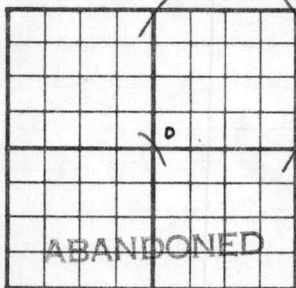County Rice State KansasSec. 11 (Blk.
Twp.) 20 (Sur.
Rge.) 10W Map No.Operator Rex & MorrisWell No. 1 Farm ScottElev. 1775 Location SW SW NE330 Ft. From S Line NW330 Ft. From W Line Quarter

1st. Report

Completion FEB 3 1954Remarks WildcatRex & Morris - Contr.Spudding Date 1-22-54Drlg. Data D & A TD 33788" @ 234 Top. 2583 Heeb. 2854Dodge 2872 Br. lime 2984 Lans. 3009DST 3176-93 open 35 min. Rec. 25' mudB. Penn. Cong. 3289 Simp. sh. 3326Simp. sd. 3334 DST 3334-40 open 1 hr.Rec. 20' mud Arb. 3346 DST 3339-48open 1 hr. Rec. 355' sul. wtr. 1050#TD 3378D & A