

Cowley

KANSAS

SECTION 19 TOWNSHIP 31 RANGE 5 E

WELL NO. #1 Kennedy

COMPANY O. H. Parker

NORTH

WEST

EAST

SOUTH

Cowley

KANSAS

SEC.	TWP.	R.
19	31	5E

WELL NO.

#1 Kennedy

FARM

COMPANY

O.H. Parker

CONTRACTOR

Wrico

Floral Gas


Ft. from N. Line

Ft. from S. Line

Ft. from E. Line

Ft. from W. Line

SE SW SE

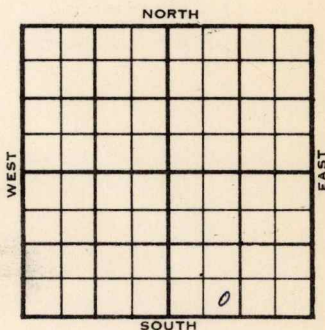

	ELEVATION	REPORT
1955	1254'	

12-21 Location

1956

1-5

Comm. 12-20-55

8 5/8" @ 103/85

DST 2257-95 op 1 hr. rec. 420' mud,
160/20"DST 2889-2914 op 1 hr. rec. 15' mud,
80/25"

D & A

Layton Zn. 2257

Layton Sd. 2269

KC. 2344

BKC 2492

Cleve 2594

Big Im. 2599

Oswego 2648

Cattleman 2789

Bart 2884

Miss 2941

TD 2962'

ABANDONED

County

Cowley

Elev.

Sec.

19

Twp.

31

Rge.

SE

Company

O. H. Parker

Farm Name

Kennedy

No.

1

TOPS

DEPTH

LOG

DATUM

Loc. in Sec.

Anh.

Tp.

H.

Tr.

Dg.

Bl.

L.

K.C.

B.K.C.

Ce.

C.

M.

M.

K.

Mz.

Mq.

V.

S.

S.

A.

R.

Pe.

G.

T.D.

SE SW SE

Geol.

Contr.

Whico

Pool

Floral Gas

FIRST REPORT

DEC 21 1955

0

Date Comm.

Location

Co.

Lse.

No.

Sec.

T.

R.

County Cowley Elev. 1254
 Sec. 19 Twp. 31 Rge. 5E
 Company O. H. Parker
 Farm Name Kennedy No. 1

TOPS	DEPTH	LOG	DATUM	Loc. in Sec.
Anh.				SE SW SE
Tr.				
H. <u>Hayden</u>	<u>32.57</u>		<u>100.3</u>	
Tr. <u>"</u>	<u>32.67</u>		<u>101.5</u>	
Dg.				
B.L.				
L.				
K.C.	<u>2.344</u>		<u>1090</u>	Geol.
B.K.C.	<u>24.92</u>		<u>12.38</u>	Contr.
Ce. <u>Cleaver</u>	<u>25.74</u>		<u>1340</u>	Wrico
C. <u>Biglin</u>	<u>25.99</u>		<u>1345</u>	
M. <u>Asquemo</u>	<u>26.48</u>		<u>1394</u>	Pool
K. <u>Cattlemans</u>	<u>27.89</u>		<u>15.35</u>	Floral Gas
Mz. <u>Bart</u>	<u>28.84</u>		<u>16.30</u>	
Me. <u>Miss</u>	<u>29.41</u>		<u>16.87</u>	
V.				
S.				
S.				
A.				
R.				
Pe.				
G.				
T.D.	<u>29.62</u>			

ABANDONED

Date Comm. 12-20-55 JAN 5 1956.
 8 5/8" @ 103/85 DST 2257-95 open 1 hr
 rec. 420' mud 160/20" DST 2889-2914
 open 1 hr. rec. 15' mud 80/25"
 D & A