


Map No. **KANSAS** Sec. *18* Twp. *31* R. *5*

Well No. *1-Shannon* Farm  
*Sam Elliott* Company

NORTH

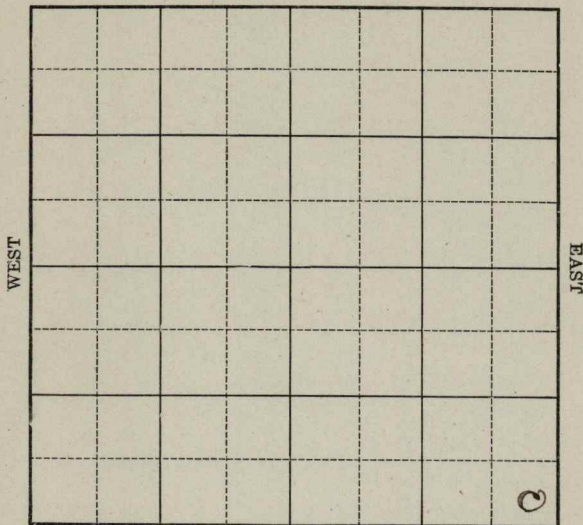

SOUTH

Location \_\_\_\_\_

Drilling Remarks \_\_\_\_\_  
\_\_\_\_\_  
\_\_\_\_\_  
Rig Up \_\_\_\_\_

Drilling Remarks \_\_\_\_\_  
\_\_\_\_\_  
\_\_\_\_\_  
**RECORD**

Cased \_\_\_\_\_ in. \_\_\_\_\_ ft.

Sand \_\_\_\_\_

Gas \_\_\_\_\_

Oil \_\_\_\_\_

Total Depth \_\_\_\_\_

**PRODUCTION**

1st 24 hrs. Nat. \_\_\_\_\_

1st 24 hrs. after shot \_\_\_\_\_

Gas \_\_\_\_\_ cu. ft.

Dry Hole \_\_\_\_\_

Abandoned \_\_\_\_\_

Map No. **KANSAS** Sec. 18 Twp. 31 R. 5

Well No. 1-Shannon Farm  
Sam Elliott Company


.....Ft. from N. Line

250 Ft. from S. Line

250 Ft. from E. Line

.....Ft. from W. Line

1928

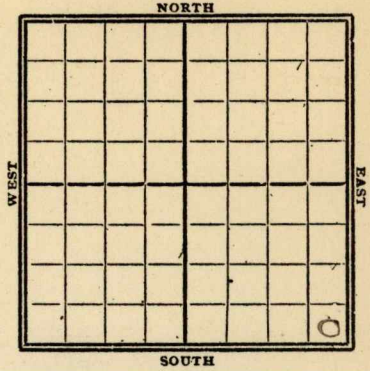

Date	REPORT
------	--------

<u>7/19</u>	<u>Mch.</u>
-------------	-------------

<u>7/26</u>	<u>July 400</u>
-------------	-----------------

<u>8/1</u>	<u>Land 482-492 1/2 # Gas</u>
------------	-------------------------------

*Cowley*

K2 KANSAS

MAP No. \_\_\_\_\_ SEC. 18 TWP. 31 R. 5

WELL No. 1 *Shannon*

*Tom Elliott* COMPANY

CONTRACTOR

FIRST REPORTS

SECTION PLAT

			0

\_\_\_\_\_ FT. FROM N. LINE

250 FT. FROM S. LINE

250 FT. FROM E. LINE

\_\_\_\_\_ FT. FROM W. LINE

LOCATION \_\_\_\_\_

RIG UP Machine

DRILLING AND REMARKS:

*[Faint handwritten notes and a red rectangular stamp]*

RECORD

CASED \_\_\_\_\_ IN., \_\_\_\_\_ FT.

SAND \_\_\_\_\_

GAS \_\_\_\_\_

OIL \_\_\_\_\_

TOTAL DEPTH \_\_\_\_\_

PRODUCTION

1ST 24 HRS. NAT. \_\_\_\_\_

1ST 24 HRS. AFTER SHOT \_\_\_\_\_

GAS \_\_\_\_\_ CU. FT.

DRY HOLE \_\_\_\_\_

ABANDONED \_\_\_\_\_

DATE

JUL 19 1928

192

CHAS. L. SHERWOOD

SCOUT

Cowley

MAP No. **2 KANSAS** SEC. 18 TWP. 31 R. 5

WELL No. 1 Shannon  
Sam Elliott

COMPANY

CONTRACTOR

**COMPLETED**

**SECTION PLAT**

			0

\_\_\_\_\_ FT. FROM N. LINE  
750 FT. FROM S. LINE  
750 FT. FROM E. LINE  
 \_\_\_\_\_ FT. FROM W. LINE

LOCATION \_\_\_\_\_

RIG UP \_\_\_\_\_

DRILLING AND REMARKS:

*gas well*

**RECORD**

CASED \_\_\_\_\_ IN. \_\_\_\_\_ FT.  
 SAND 482-492  
 GAS \_\_\_\_\_  
 OIL \_\_\_\_\_  
 TOTAL DEPTH 492

**PRODUCTION**

1ST 24 HRS. NAT. \_\_\_\_\_  
 1ST 24 HRS. AFTER SHOT \_\_\_\_\_  
 GAS 1/2 44 CU. FT.  
 DRY HOLE \_\_\_\_\_  
 ABANDONED \_\_\_\_\_

DATE

**AUG 1 1928**

**CHAS. L. SHERWOOD**

192

SCOUT