


Map No. 15 Sec. 18 Twp. 31 R. 5  
Well No. 1. Willis or Shannon Farm  
Ark. Fuel Gas Company

10651000

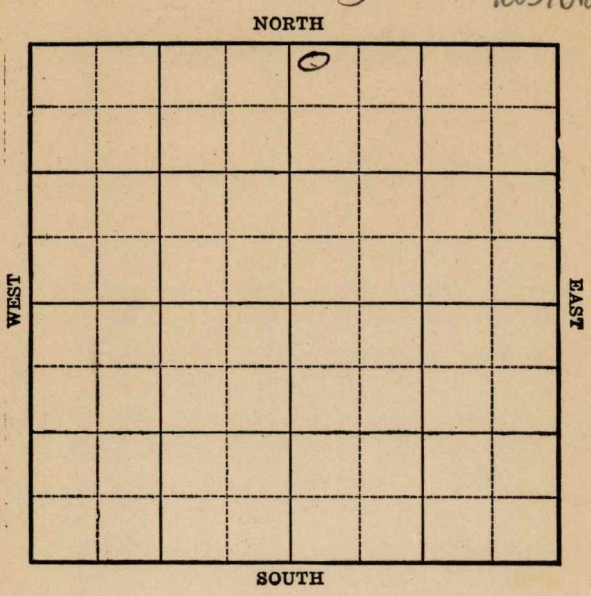

Location \_\_\_\_\_

Rig up \_\_\_\_\_

Drilling Remarks:

Drilling Remarks:

\_\_\_\_\_

\_\_\_\_\_

**RECORD**

**PRODUCTION**

Cased \_\_\_\_\_ in. \_\_\_\_\_ ft.

1st 24 hrs Nat. \_\_\_\_\_

Sand \_\_\_\_\_

1st 24 hrs. after shot \_\_\_\_\_

Gas \_\_\_\_\_

Gas \_\_\_\_\_ cu. ft.

Oil \_\_\_\_\_

Dry Hole \_\_\_\_\_

Total Depth \_\_\_\_\_

Abandoned \_\_\_\_\_



2 **KANSAS** Map No. \_\_\_\_\_ Sec. 18 Twp. 31 R. 5

Well No. 1 Wilks or Shannon - ICGS  
Ark River Gas Company

Contractor \_\_\_\_\_

**FIRST REPORT SECTION PLAT**

200 Ft. from N. Line

\_\_\_\_\_ Ft. from S. Line

\_\_\_\_\_ Ft. from E. Line

200 Ft. from W. Line

		0	

Location \_\_\_\_\_

Rig up \_\_\_\_\_

Drilling and Remarks:

*Timbers*

**RECORD**

Cased \_\_\_\_\_ in., \_\_\_\_\_ ft.

Sand \_\_\_\_\_

Gas \_\_\_\_\_

Oil \_\_\_\_\_

Total Depth \_\_\_\_\_

**PRODUCTION**

1st 24 hrs. Nat. \_\_\_\_\_

1st 24 hrs. after shot \_\_\_\_\_

Gas \_\_\_\_\_ Cu. Ft.

Dry Hole \_\_\_\_\_

Abandoned \_\_\_\_\_

Date

MAY 22 1924

192

M. A. BENEAR

Scout

2 **KANSAS** Map No. Sec. 18 Twp. 31 R. 5

Well No. 1 Shannon

Park River Gas Co. Company

Contractor

**ABANDONED SECTION PLAT**

200 Ft. from N. Line  
Ft. from S. Line  
Ft. from E. Line  
200 Ft. from W. Line

		0	

Location \_\_\_\_\_  
Rig up \_\_\_\_\_  
Drilling and Remarks:  
Tap Line 2930'  
will 3380 N. 7. W  
L049 3521'

**RECORD**

Cased \_\_\_\_\_ in., \_\_\_\_\_ ft.  
Sand \_\_\_\_\_  
Gas \_\_\_\_\_  
Oil \_\_\_\_\_  
Total Depth \_\_\_\_\_

**PRODUCTION**

1st 24 hrs. Nat. \_\_\_\_\_  
1st 24 hrs. after shot \_\_\_\_\_  
Gas \_\_\_\_\_ Cu. Ft.  
Dry Hole \_\_\_\_\_  
Abandoned \_\_\_\_\_

Date 1/14 1925

M. A. BENEAR Scout