


Cowley

Form 51-5M-4-27-27423

Map No. **KANSAS** Sec. 19 Twp. 31 R. 5

Well No. 2 - Clay bough Farm
Barnsdall Oil Co Company

NORTH

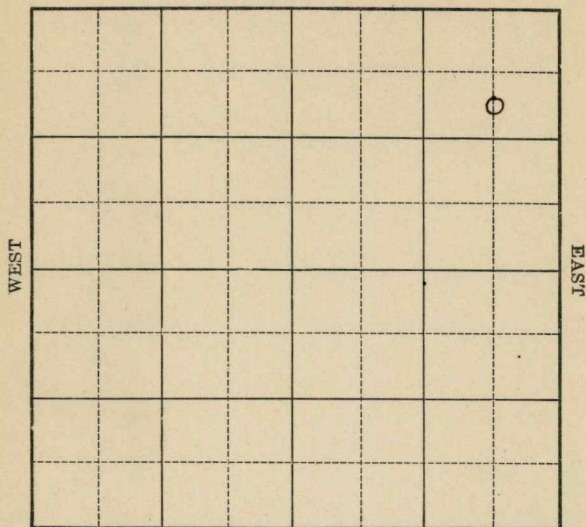

SOUTH

Location _____

Drilling Remarks _____

Rig Up _____

Drilling Remarks _____

RECORD

Cased _____ in. _____ ft.

Sand _____

Gas _____

Oil _____

Total Depth _____

PRODUCTION

1st 24 hrs. Nat. _____

1st 24 hrs. after shot _____

Gas _____ cu. ft.

Dry Hole _____

Abandoned _____


Map No. **KANSAS** Sec. 19 Twp. 31 R. 5
Well No. 2 - Play bough Farm
Barnsdall Oil Co Company

900 Ft. from N. Line

.....Ft. from S. Line

650 Ft. from E. Line

-----Ft. from W. Line

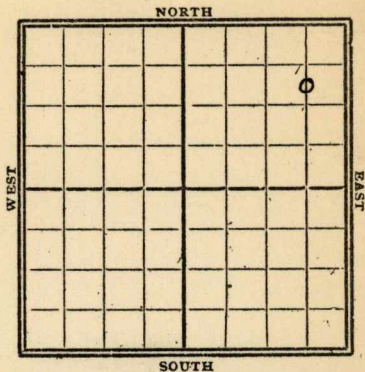

1928

Date _____

REPORT

10/10	Rign up.
10/17	drlg 355'
10/24	S.D. 600'
10/31	Abd 4'D. 600'

Cowley

KANSAS

MAP NO. _____ SEC. 19 TWP. 31 R. 5

WELL NO. 2 Claybaugh

Barnsdall Oil Co COMPANY

CONTRACTOR

FIRST REPORTS

SECTION PLAT

			0

900 FT. FROM N. LINE

_____ FT. FROM S. LINE

650 FT. FROM E. LINE

_____ FT. FROM W. LINE

LOCATION _____

RIG UP _____

DRILLING AND REMARKS: _____

RECORD

CASED _____ IN. _____ FT.

SAND _____

GAS _____

OIL _____

TOTAL DEPTH _____

PRODUCTION

1ST 24 HRS. NAT. _____

1ST 24 HRS. AFTER SHOT _____

GAS _____ CU. FT.

DRY HOLE _____

ABANDONED _____

DATE

OCT 10 1928

CHAS. L. SHERWOOD

192

SCOUT

K2 KANSAS

MAP NO. _____ SEC. 19 TWP. 31 R. 5WELL NO. 2Clay Comb
Barnsdall Oil Co

COMPANY

CONTRACTOR

COMPLETED

SECTION PLAT

			0

900 FT. FROM N. LINE

_____ FT. FROM S. LINE

650 FT. FROM E. LINE

_____ FT. FROM W. LINE

ABANDONED

LOCATION _____

RIG UP _____

DRILLING AND REMARKS:

RECORD

CASED _____ IN. _____ FT.

SAND _____

GAS _____

OIL _____

TOTAL DEPTH 600

PRODUCTION

1ST 24 HRS. NAT. _____

1ST 24 HRS. AFTER SHOT _____

GAS _____ Cu. Ft.

DRY HOLE ☒ABANDONED ☒

DATE

OCT 31 1928

CHAS. L. SHERWOOD

192

SCOUT