FORM 51 10M 8-47

Rice
KANSAS

Section 11 Township 20 Range 10-W

Well No. #2 Hilderbrand

Company J C Dozier etal

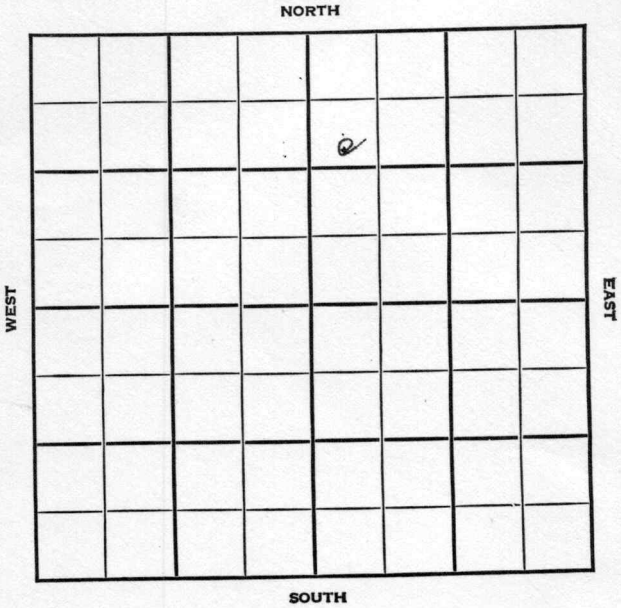

FORM 252-A
5M 4-48 PETROL

KANSAS

Rice

Sec. 11 Twp. 20 R. 10W

Well No. #2 Hilderbrand Farm

J. C. Dozier et al Company

No name

1118' Ft. from N. Line

Ft. from S. Line

Ft. from E. Line

330' Ft. from W. Line

SW NW NE Twin Well

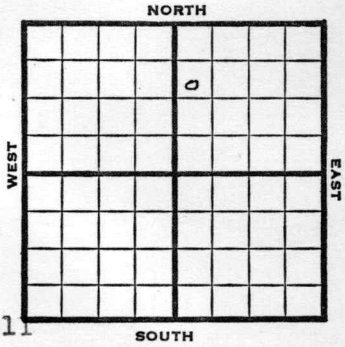

1948	REPORT Eli 1770'
6/30	10" @ 209' Drlg. 1625'
7/8	Lansing 3022' Simpson Sand 3297' TD 3307' fsg.
7/14	" "
7/21	" W
7/28	Simp Sd 3297' TD 3307' Lost pipe in hole Aband. ABANDONED

Form 26—200 Bks.—1-48—Palace

Kansas

No name

Map No._____ Sec. 11 Twp. 20 R. 10W

Well No. 2 Hilderbrand

J. C. Dozier etal. Company

FIRST REPORT

Contractor

SW NW NE

SECTION PLAT

1115 Ft. from N. Line

262 Ft. from S. Line

_____ Ft. from E. Line

330 Ft. from W. Line

Rice County

Location_____

Rig up_____

Drilling and Remarks:

10" @ 209

drlg. 1625

twin well

RECORD

Cased_____ in., _____ ft.

Sand_____

Gas_____

Oil_____

Total Depth_____

PRODUCTION

1st 24 hrs. Nat._____

1st 24 hrs. after shot_____

Gas_____ Cu. Ft.

Dry Hole_____

Abandoned_____

Date

JUN 30 1948 19____ S. J. LEWIS Scout

Form 27—100 Bks.—4-48—Petrol

Rice County Kansas State

Map No. 46 Sec. 11 Twp. 20 R. 10W

Well No. 2 Hilderbrand

J. C. Dozier etal. Company

ABANDONED Contractor

SW NW NE

El. 1770

SECTION PLAT

1118 Ft. from N. Line

Ft. from S. Line

Ft. from E. Line

330 Ft. from W. Line

No name

Remarks:

Emp. Ab 8287

TD 8307

Lost pipe in hole

Date JUL 28 1948

Scout S. J. LEWIS