

KANSAS


Rice

FORM 51 5M 6-46 PETROL

Section 12 Township 20 Range 10-W

Well No. #2 ^{MC} cFarland

Company T.C. Hyde et al

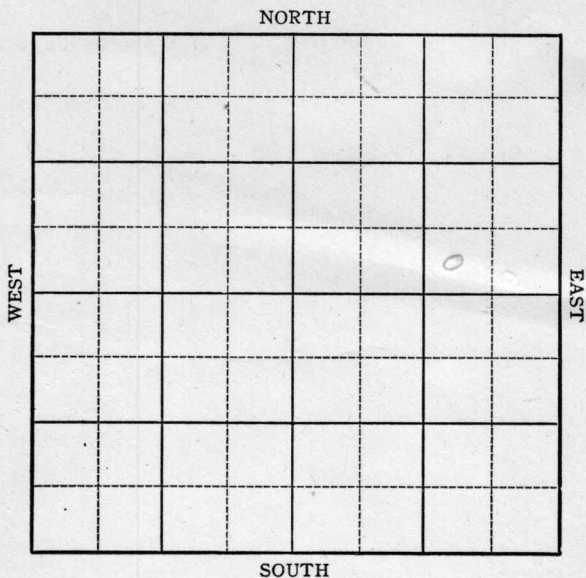

KANSAS

Rice County

Sec. 12 Twp. 20 R. 10W

Well No. #2 McFarland Farm
G. C. Hyde et al Company

Chase


 Ft. from N. Line

330 Ft. from S. Line

990 Ft. from E. Line

 Ft. from W. Line

SW SE NE

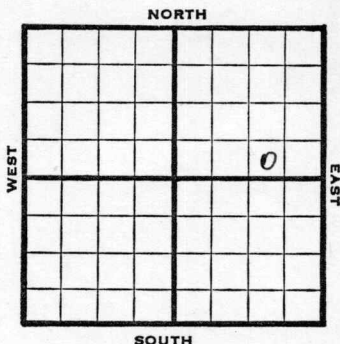

1946

1752

REPORT

8/21 175 run csg.
8/27 Drlg 2640'!
10" @ 132'
9/5 TD 3285
5" @ 3285'
RUST
9/10 36 shots 3045-55
wtr 1000 acid, sqz.
9/18 " "
9/24 Arb 3279
5" @ 3279'
TD3285'
10/2 Arb 3279'
5" @ 3279'
TD 3285'
Pump 100 POT
Grav 42.7

COMPLETED


Kansas Pool Name ChaseMap No. KANSAS 26 Sec. 12 Twp. 20 R. 10WWell No. 2 McFarlandG. C. Hyde et al. Company

FIRST REPORT

Contractor

SW SE NE

SECTION PLAT

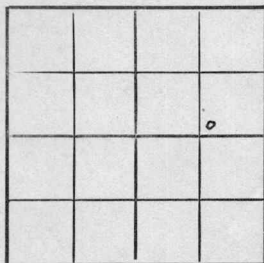 Ft. from N. Line330 Ft. from S. Line990 Ft. from E. Line Ft. from W. LineRice CountyLocation Rig up

Drilling and Remarks:

175 run csg.

RECORD

Cased in., ft.Sand Gas Oil Total Depth

PRODUCTION

1st 24 hrs. Nat. 1st 24 hrs. after shot Gas Cu. Ft.Dry Hole Abandoned

Date

AUG 21 1946 19S. J. LEWIS Scout

KANSAS

Kansas

Pool Name Chase PoolMap No. 46 Sec. 12 Twp. 20 R. 10WWell No. 2 McFarlandG. C. Hyde et al.

Company

COMPLETED

Contractor

SW SE NE

E11/252
SECTION PLAT

Ft. from N. Line330 Ft. from S. Line990 Ft. from E. LineFt. from W. LineRice County

Location

Rig up

Drilling and Remarks:

Ar 432795" @ 3279Pump 10042 3/4

RECORD

Cased _____ in., _____ ft.

Sand _____

Gas _____

Oil _____

Total Depth 3275

PRODUCTION

1st 24 hrs. Nat. _____

1st 24 hrs. after shot _____

Gas _____ Cu. Ft.

Dry Hole _____

Abandoned _____

Date

OCT 2 1946 19S. J. LEWIS

Scout