


Map No. **KANSAS** Sec. 31 Twp. 31 R. 5
 Well No. 1-Elliott Farm
Sam Elliott Company

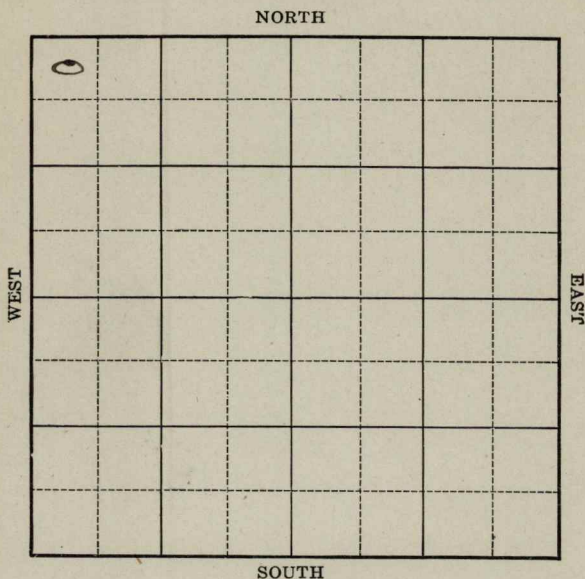

Location _____

Drilling Remarks _____

RECORD

Cased _____ in. _____ ft.

Sand _____

Gas _____

Oil _____

Total Depth _____

Rig Up _____

Drilling Remarks _____

PRODUCTION

1st 24 hrs. Nat. _____

1st 24 hrs. after shot _____

Gas _____ cu. ft.

Dry Hole _____

Abandoned _____

Map No. **KANSAS** Sec. 21 Twp. 31 R. 5
Well No. 1-Elliott Farm
Sam Elliott Company


NORTH

300 Ft. from N. Line

_____ Ft. from S. Line

_____ Ft. from E. Line

300 Ft. from W. Line

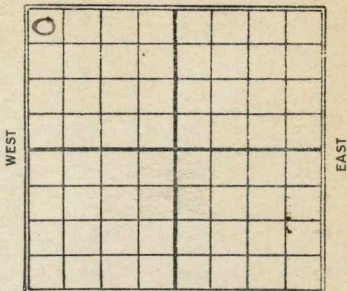

SOUTH

1928

Date

REPORT

7/5 Wrlg. 630'
7/13 _____
7/19 N.A. 632'

Cowley
K2 KANSAS Map No. _____ Sec. *21* Twp. *31* R. *5*

Well No. *1* *Elliot*
Sam Elliot Company

Contractor

FIRST REPORTS

SECTION PLAT

300 Ft. from N. Line

_____ Ft. from S. Line

_____ Ft. from E. Line

300 Ft. from W. Line

<i>0</i>			

Location _____

Rig up _____

Drilling and Remarks:

RECORD

Cased _____ in., _____ ft.

Sand _____

Gas _____

Oil _____

Total Depth _____

PRODUCTION

1st 24 hrs. Nat. _____

1st 24 hrs. after shot _____

Gas _____ Cu. Ft.

Dry Hole _____

Abandoned _____

Date

JUL 5 1928 **CHAS. L. SHERWOOD**

192 _____ Scout

Cowley
K2 KANSAS
 MAP NO. _____ SEC. 21 TWP. 31 R. 5

WELL NO. 1 Elliott
Sam Elliott COMPANY

CONTRACTOR

COMPLETED

300 FT. FROM N. LINE

_____ FT. FROM S. LINE

_____ FT. FROM E. LINE

300 FT. FROM W. LINE

ABANDONED**SECTION PLAT**

0			

LOCATION _____

RIG UP _____

DRILLING AND REMARKS:

DQay 63r

RECORD

CASED _____ IN. _____ FT.

SAND _____

GAS _____

OIL _____

TOTAL DEPTH 632**PRODUCTION**

1ST 24 HRS. NAT. _____

1ST 24 HRS. AFTER SHOT _____

GAS _____ Cu. Ft.

DRY HOLE ☒ABANDONED ☒

DATE

JUL 19 1928

CHAS. L. SHERWOOD

192

SCOUT