


KANSAS

Gowley

Section 20 Township 31 Range 5-E

Well No. #1 Bement

Company Hill & Hill
Miscellaneous

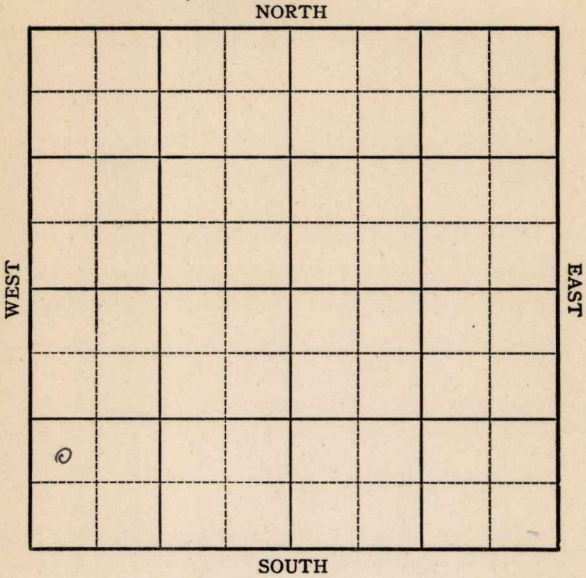

Sec. 20 Twp. 31 R. 5E ✓

Well No. #1 Bement Farm

Hill & Hill Company

Norrison Drlg. Contractor

Miscellaneous


Ft. from N. Line

990' Ft. from S. Line

Ft. from E. Line

330' Ft. from W. Line

NW SW SW

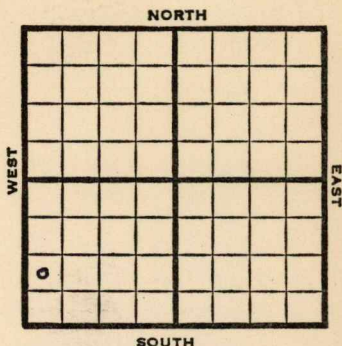

1949

lev 1283' REPORT

11/9 8" @ 90'

Drlg. 350'

11/16 Layton 2258-64'

TD 2264'

7" @ 2258'

11/23 Drlg. 2283'

11/30 TD 2309'

Sand 2264'

Aband.

ABANDONED

Map No. _____ Sec. 20 Twp. 31 R. 5E

Well No. 1 Bement

Hill & Hill Company

Morrison Drlg. Contractor

NW SW SW

FIRST REPORT
SECTION PLAT

_____ Ft. from N. Line

990 Ft. from S. Line

_____ Ft. from E. Line

330 Ft. from W. Line

0			

Cowley County

Location _____

Rig up _____

Drilling and Remarks:

8" @ 90

drlg. 350

RECORD

Cased _____ in., _____ ft.

Sand _____

Gas _____

Oil _____

Total Depth _____

PRODUCTION

1st 24 hrs. Nat. _____

1st 24 hrs. after shot _____

Gas _____ Cu. Ft.

Dry Hole _____

Abandoned _____

Date

NOV 9 1949 19

S. J. LEWIS

Scout

Map No. _____ Sec. 20 Twp. 31 R. 5E

Well No. 1 Bement

Hill & Hill

Company

ABANDONED

Contractor

NW SW SW

E 41283
SECTION PLAT

_____ Ft. from N. Line

990 Ft. from S. Line

_____ Ft. from E. Line

330 Ft. from W. Line

Cowley County

Location _____

Rig up _____

Drilling and Remarks:

Shand 2264

RECORD

Cased _____ in., _____ ft.

Sand _____

Gas _____

Oil _____

Total Depth 2180

PRODUCTION

1st 24 hrs. Nat. _____

1st 24 hrs. after shot _____

Gas _____ Cu. Ft.

Dry Hole _____

Abandoned _____

Date

NOV 30 1949 19

S. J. LEWIS Scout