

Section 12 Township 20 Range 10 WWell No. # 10 Logan-ShonyoCompany D. R. Lauck

NORTH

WEST

EAST

SOUTH

O

Rice

KANSAS

Sec. 12 Twp. 20 R. 10 W ✓

Well No. # 10 Logan-Shonyo Farm

D. R. Lauck Company

Contractor

Chase Pool

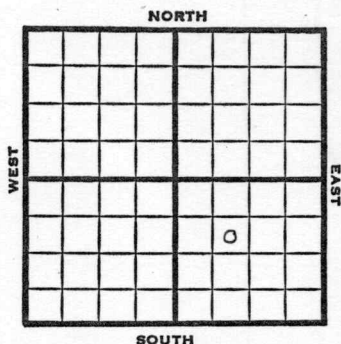
990 Ft. from N. Line

 Ft. from S. Line

 Ft. from E. Line

990 Ft. from W. Line

SE NW SE



1951

Elev. 1757'

REPORT

5/29

10" @ 145

Drlg. 300'

6/20

Spud 5-27-51

Oil well TD 3290' 10" @ 145

Anhy 680' Heeb 2813' Br. lime 2942

KC 2974'

DST 2987-98 open 15 min. rec 4' mud

DST 3011-43 open 15 min. rec 4' mud

DST 3048-59 open 1 hr. rec 12' SOCM

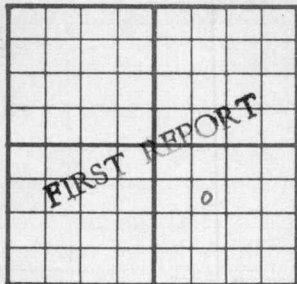
Cong. 3259' Arb. 3281-90

5" @ 3282' 23/3053-59 1000 A

S/2-3/4 BO 3/4 BWPH

Comp. 40 BOPD

COMPLETED

County Rice State KansasSec. 12 (Blk.) 20 (Sur.) 10W Map No.Operator D. R. LauckWell No. 10 Farm Logan - ShonyoElev. _____ Location SE NW SE990 Ft. From N Line SE990 Ft. From W Line Quarter1st. Report MAY 29 1951

Completion _____

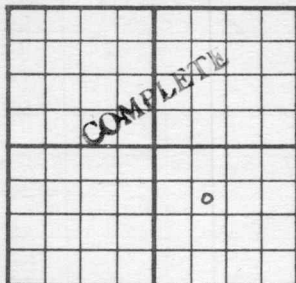
Remarks _____

Spudding Date _____

Drlg. Data

Chase Pool10" @ 145 drlg. 300

J. E. TYRA

County Rice State KansasSec. 12 (Blk.
Twps.) 20 (Sur.
Rge.) 10W Map No.Operator D. R. LauckWell No. 10 Farm Logan - ShonyoElev. 1757 Location SE NW SE990 Ft. From N Line SE990 Ft. From W Line Quarter

1st. Report _____

Completion JUN 20 1951Remarks Chase PoolSpudding Date 5-27-51Drlg. Data Oil well TD 329010" @ 145 Anhy 680 Heeb. 2813Br. lime 2942 KC 2974 DST 2987-98open 15 min. Rec. 4' mud DST 3011-43open 15 min. Rec. 4' mud DST 3048-59open 1 hr. Rec. 12' socm Cong. 3259Arb. 3281-90 5" @ 3282 23/ 3053-591000 A S/ 2 3/4 bo 3/4 bwphComp. 40 bopd

J. E. TYRA