


Section 27 Township 31 Range 5-E

Well No. #1 Craig "A"

Company E Wakefield etal
Miscellaneous

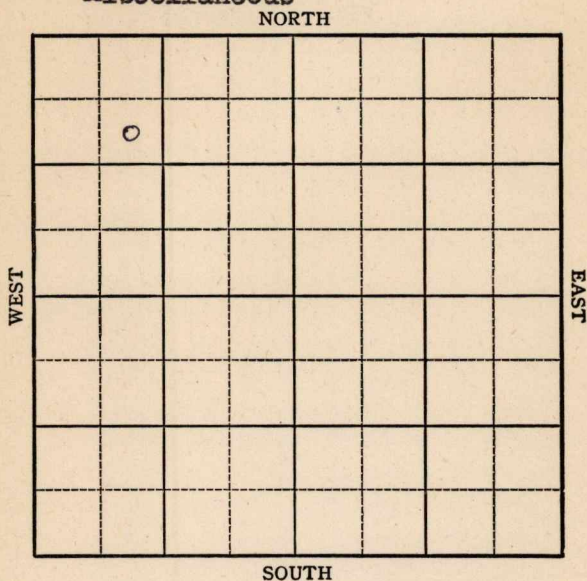

Cowley

Sec. 27 Twp. 31 R. 5E

Well No. #1 Craig "A" Farm

E. Wakefield et al

Company

Miscellaneous


990' Ft. from N. Line

Ft. from S. Line

Ft. from E. Line

990' Ft. from W. Line

SE NW NW

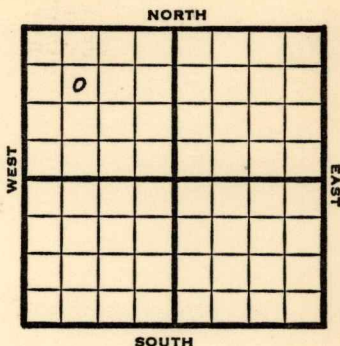

1949

Elev. 1299' REPORT

11/16

Location

11/23

Surface Hole

11/29

8"@ 120'

Drlg 755'

12/7

Layton 2279'

TD 3307'

5"@ 3299'

12/14

Layton 2279'

TD 2307'

ABANDONED

Map No. _____ Sec. 27 Twp. 31 R. 5E

Well No. 1 Craig "A"

E. Wakefield etal. Company

Wakefield Contractor

SE NW NW


FIRST REPORT
SECTION PLAT

990 Ft. from N. Line

_____ Ft. from S. Line

_____ Ft. from E. Line

990 Ft. from W. Line

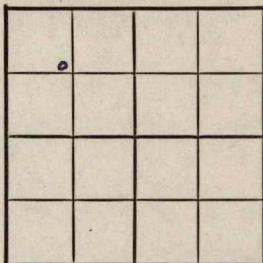

Cowley County

Location X

Rig up _____

Drilling and Remarks:

RECORD

Cased _____ in., _____ ft.

Sand _____

Gas _____

Oil _____

Total Depth _____

PRODUCTION

1st 24 hrs. Nat. _____

1st 24 hrs. after shot _____

Gas _____ Cu. Ft.

Dry Hole _____

Abandoned _____

Date

NOV 16 1949 19

S. J. LEWIS Scout

Kansas

Miscellaneous

Map No. _____ Sec. 27 Twp. 31 R. 5EWell No. 1 Craig "A"E. Wakefield et al. Company

ABANDONED

Contractor

SE NW NW

E. 11298
SECTION PLAT990 Ft. from N. Line

_____ Ft. from S. Line

_____ Ft. from E. Line

990 Ft. from W. Line

5			

Cowley County

Location _____

Rig up _____

Drilling and Remarks:

Layton 2278

RECORD

Cased _____ in., _____ ft.

Sand _____

Gas _____

Oil _____

Total Depth 2202

PRODUCTION

1st 24 hrs. Nat. _____

1st 24 hrs. after shot _____

Gas _____ Cu. Ft.

Dry Hole _____

Abandoned _____

Date

DEC 14 1949

19

S. J. LEWIS

Scout