


Rice

Form 51-5M-5-34-Palace

Map No. KANSAS Sec. 13 Twp. 20 R. 10^W

Well No. 1 Miller Farm _____
Empire Company _____

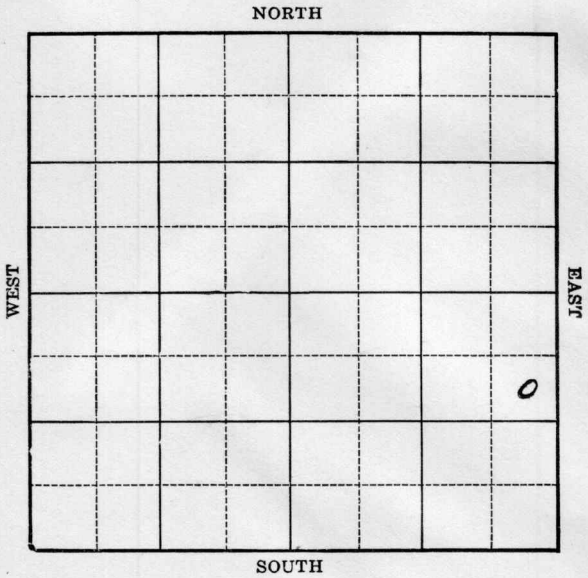

Location _____
Drilling Remarks _____

Rig Up _____
Drilling Remarks _____

RECORD

Cased _____ in. _____ ft.
Sand _____
Gas _____
Oil _____
Total Depth _____


PRODUCTION

1st 24 hrs. Nat. _____
1st 24 hrs. after shot _____
Gas _____ cu. ft. _____
Dry Hole _____
Abandoned _____

Rice

Map No. KANSAS Sec. 13 Twp 20 R. 10 W
Well No. 1 Miller Farm _____
Empire Company

990 Ft. from N. Line
____ Ft. from S. Line
330 Ft. from E. Line
____ Ft. from W. Line

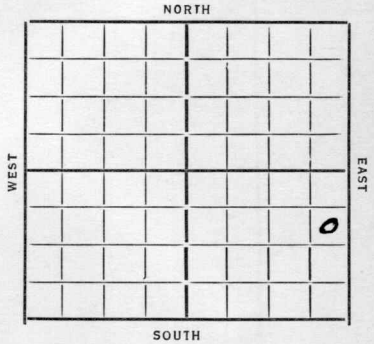

Date	REPORT
7/18	Location
7/26	Rdgy.
8/2	
8/9	20" 86 15 1/2 405 57 665
8/16	dly 1300
8/23	" 2080 12 1/2 1168 10" 1900
8/30	" 2625 HFW 2565-75 8" 2605
9/6	" 3050
9/13	Conglomerate 3315 TD 3325 2 1/2" 6"
9/20	Siliceous 3342 TD 3343 6" 3342 P.B.P.
9/27	TD 3345 1/2 2865' oil 9 1/2 hrs.
10/3	Siliceous 3342 TD 3345 1/2 Potential 779 oil 30 water

COMPLETED

KANSAS

Map No. 46 Sec. 13 Twp. 20 R. 10ⁿ

Well No. 1-Miller

Empire

Company

Contractor

FIRST REPORTS

SECTION PLAT

990 Ft. from N. Line

_____ Ft. from S. Line

330 Ft. from E. Line

_____ Ft. from W. Line

Location ✓

Rig up _____

Drilling and Remarks:

RECORD

Cased _____ in., _____ ft.

Sand _____

Gas _____

Oil _____

Total Depth _____

PRODUCTION

1st 24 hrs. Nat. _____

1st 24 hrs. after shot _____

Gas _____ Cu. Ft.

Dry Hole _____

Abandoned _____

Date

7-18-34 19

ORVAL MANNSCHREIN Scout

KANSAS

Map No. 46 Sec. 13 Twp. 20 R. 10WWell No. 1 MillerEmpire Oil

Company

Contractor

COMPLETED

SECTION PLAT

990 Ft. from N. Line

Ft. from S. Line

330 Ft. from E. Line

Ft. from W. Line

			0

Location

Rig up

Drilling and Remarks:

potential
779 oil
30 water

RECORD

Cased _____ in., _____ ft.

Sand siliceous 3342

Gas _____

Oil _____

Total Depth 3345 1/2

PRODUCTION

1st 24 hrs. Nat. _____

1st 24 hrs. after shot _____

Gas _____ Cu. Ft.

Dry Hole _____

Abandoned _____

Date

10-3-34 192 ORVAL MANNSCHRECK Scout