


# KANSAS Rice county

Section 12 Township 20 Range 10W

Well No. #4, Logan-Shoyo

Company Lauck & Monnreif

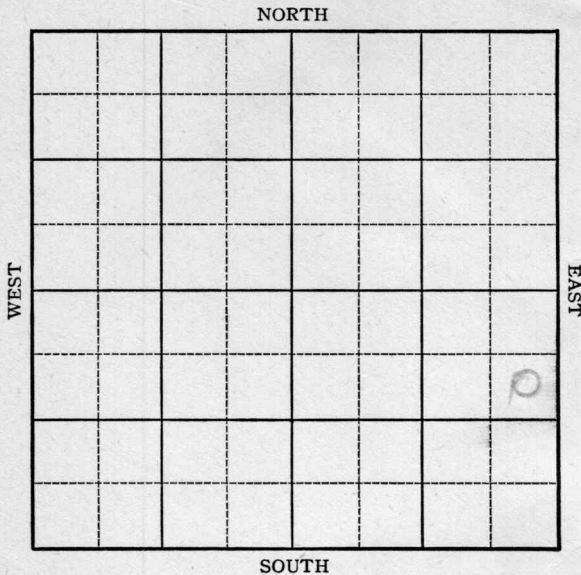

KANSAS Rice County

Sec. 12 Twp. 20 R. 10W

Well No. #4 Logan-Shoyno Farm  
Lauck & Moncrief Company

Silica


990 Ft. from N. Line

Ft. from S. Line

330 Ft. from E. Line

Ft. from W. Line

SE NE SE

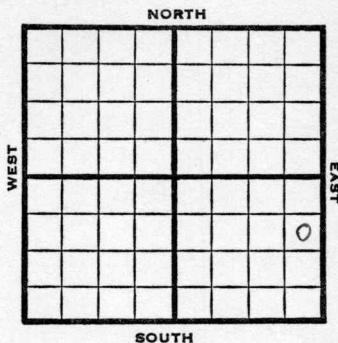

1946 Elev 1751' REPORT

5/15 RUR

5/21 10" @ 3266  
Drlg 1250'

5/29 Drlg. 2982'

6/5 Lans 2969

Arb. 3266

7" @ 3266

TD 3277 $\frac{1}{2}$

500' oil 6 hrs.

6/12 Arb 3266

7" @ 3266

500 acid

Pump 800 Pot

42.0 Gr.

TD 3382'

COMPLETED

**KANSAS**Kansas Pool Name SilicaMap No. 46 Sec. 12 Twp. 20 R. 10WWell No. 4 Logan-ShoynoLauck & Moncrief


Company

CORRECTION of first report

Contractor

SE NE SE

## SECTION PLAT

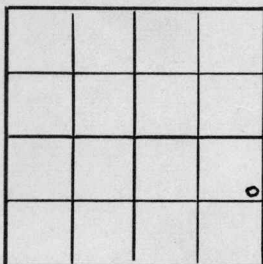990 Ft. from N. Line       Ft. from S. Line330 Ft. from E. Line       Ft. from W. LineRice CountyLocation                     Rig up                     

Drilling and Remarks:

Reported as  
#1 Logan-Shoyno

## RECORD

Cased            in.,            ft.Sand                                     Gas                                     Oil                                     Total Depth                                     

## PRODUCTION

1st 24 hrs. Nat.                                     1st 24 hrs. after shot                                     Gas                                      Cu. Ft.Dry Hole                                     Abandoned                                     

Date

MAY 15 1946 19S. J. LEWIS

Scout

KANSAS Pool Name Silica PoolMap No. 46 Sec. 12 Twp. 20 R. 10WWell No. 4 Logan-ShoynoLauch & Moncrief

Company

**COMPLETED**

Contractor


SE NE SE

E1,1251  
SECTION PLAT990 Ft. from N. Line

Ft. from S. Line

330 Ft. from E. Line

Ft. from W. Line

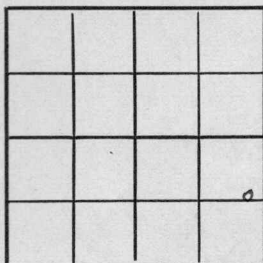Rice County

Location

Rig up

Drilling and Remarks:

*Ar 83266*  
*7' 00 3266*  
*500 acid*  
*Pump 500 ft*

*42 c***RECORD**

Cased \_\_\_\_\_ in., \_\_\_\_\_ ft.

Sand \_\_\_\_\_

Gas \_\_\_\_\_

Oil \_\_\_\_\_

Total Depth 3382**PRODUCTION**

1st 24 hrs. Nat. \_\_\_\_\_

1st 24 hrs. after shot \_\_\_\_\_

Gas \_\_\_\_\_ Cu. Ft.

Dry Hole \_\_\_\_\_

Abandoned \_\_\_\_\_

Date

JUN 12 1946 19S. J. LEWIS

Scout