


Rice county

KANSAS

Section 12 Township 20 Range 10-W

Well No. #4, McFarland

Company B.C. Hyde Jr.

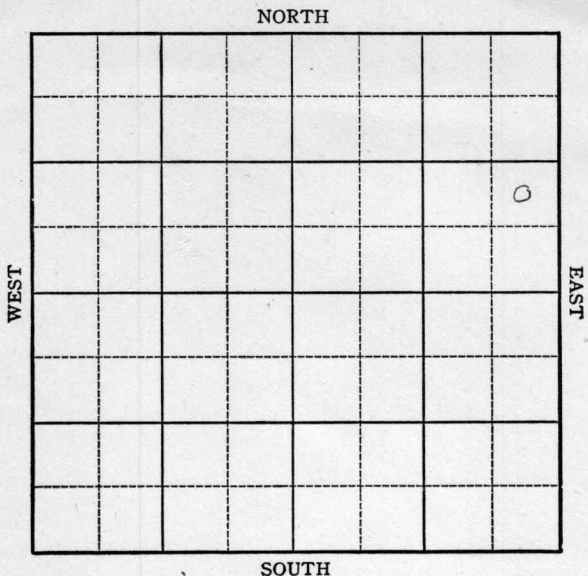

KANSAS

Rice County

Sec. 12 Twp. 20 R. 10W

Well No. #4 McFarland Farm
B.C. Hyde Jr. Company


Chase

Ft. from N. Line

990 Ft. from S. Line

330 Ft. from E. Line

Ft. from W. Line

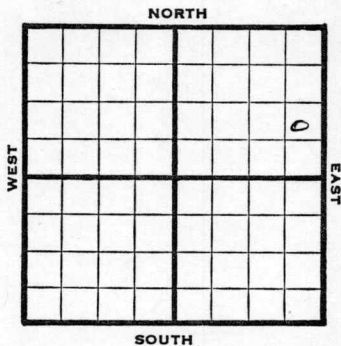

NE SE NE

1946

1746

REPORT

9/25	Location
10/1	10" @ 123'
	Anhy 375'
	Drlg 407'
10/8	Drlg 2239'
10/15	Lans 2944'
	Arb 3267-68 TD
	5" @ 3267' RUST
10/22	" " " "
10/29	" " " "
11/6	Arb 3267'
	5" @ 3267'
	TD 3269'
	Pump 100 POT
	Grav. 42.3

COMPLETED

KANSAS

Kansas Pool Name ChaseMap No. 46 Sec. 12 Twp. 20 R. 10WWell No. 4 McFarlandB. C. Hyde, Jr.

Company

FIRST REPORT

Contractor

NE SE NE

SECTION PLAT

			o

 Ft. from N. Line990 Ft. from S. Line330 Ft. from E. Line Ft. from W. LineRice CountyLocation XRig up

Drilling and Remarks:

RECORD

Cased in., ft.Sand Gas Oil Total Depth

PRODUCTION

1st 24 hrs. Nat. 1st 24 hrs. after shot Gas Cu. Ft.Dry Hole Abandoned

Date

SEP 25 1946

19

S. J. LEWIS

Scout

Map No. 46 Sec. 12 Twp. 20 R. 10W

Well No. 4 McFarland

B. C. Hyde, Jr. Company

COMPLETED

Contractor

NE SE NE

E 11746
SECTION PLAT

 Ft. from N. Line

990 Ft. from S. Line

330 Ft. from E. Line

 Ft. from W. Line

			6

Rice County

Location

Rig up

Drilling and Remarks:

ERT 3267

5" @ 3267

Pump 100 Bx

42 B. G.

RECORD

Cased in., ft.

Sand

Gas

Oil

Total Depth 3267

PRODUCTION

1st 24 hrs. Nat.

1st 24 hrs. after shot

Gas Cu. Ft.

Dry Hole

Abandoned

Date

NOV 6 1946 19

S. J. LEWIS

Scout